

- LEGEND:**
- PROJECT BOUNDARY
 - - - SECTION LINES
 - - - RIGHT-OF-WAY LINES
 - - - LOTS LINES
 - - - EASEMENT LINES
 - 900 - EX. 5' INDEX CONTOUR
 - 1' - EX. 1' INTERVAL CONTOUR
 - - - EX. PAVED ROAD
 - - - EX. GRAVEL ROAD
 - X - EX. FENCE
 - S10 - EX. CULVERT
 - POH - EX. OVERHEAD POWER
 - CORN - EX. CORN CROP LINE
 - - - EX. WETLAND
 - - - PROPOSED SINGLE AXIS TRACKER
 - - - PROPOSED MODULE SETBACK
 - - - PROPOSED ACCESS ROAD
 - X - PROPOSED SECURITY FENCE
 - - - PROPOSED ELECTRICAL EQUIPMENT
 - - - PROPOSED LAYDOWN AREA
 - - - PROPOSED TOPSOIL STORAGE
 - - - PROPOSED UNDERGROUND COLLECTION
 - - - PROPOSED OVERHEAD COLLECTION
 - - - PROPOSED STORMWATER BASIN AND BERM

- GENERAL NOTES:**
1. PARKING OF ANY PERSONAL OR DELIVERY VEHICLES WITHIN PUBLIC RIGHT OF WAY IS PROHIBITED
 2. ALL ELECTRICAL COMPONENT ARE SHOWN FOR REFERENCE ONLY. REFER TO APPLICABLE ELECTRICAL DRAWINGS FOR DETAILED ELECTRICAL DESIGNS.

STRUCTURAL SETBACKS		
	COUNTY ORDINANCE SETBACK	PROVIDED
NORTH YARD	100'	155'
EAST YARD	100'	692'
WEST YARD	100'	121'
SOUTH YARD	100'	412'

Westwood

Phone (608) 821-6600 8401 Greenway Blvd., Suite 400
Middleton, WI 53562
westwoodps.com

Westwood Professional Services, Inc.

I hereby certify that this plan was prepared by me or under my direct supervision and that I am a duly licensed PROFESSIONAL ENGINEER under the laws of the State of Minnesota.

Print Name Matthew Philip Gaarder

Signature *Matthew Philip Gaarder*

Date: 05/06/2022

License No. 52215


PREPARED FOR:



100 N 6th St. #410b
Minneapolis, MN 55403

REVISIONS:

#	DATE	COMMENT
A	04/29/22	Issued for 90% Review
B	05/06/22	Issued for Permit

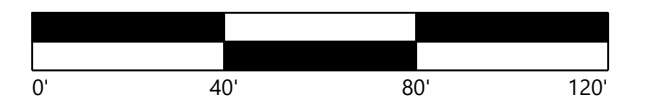

**USS Spring
Prairie Solar LLC**
Clay County, Minnesota
14873 90th Ave. N,
Glyndon, MN 56547

PV Site Plan

ISSUED FOR PERMIT

DATE: 05/06/2022

SHEET: C200

24/01/2022 10:40 AM C:\GIS\Drawings\400\400.dwg 01.dwg 15/05/2022 2:31 PM Samantha Mawel