


# LINDEN TRAILS SUBDIVISION

NORTHEAST QUARTER OF THE NORTHEAST QUARTER SECTION 10 TOWNSHIP 140 N RANGE 48 W  
CLAY COUNTY, MINNESOTA

**OWNER**  
CV PROPERTIES  
CHRIS VANDERLINDEN  
2660 16TH AVENUE SOUTH  
MOORHEAD, MN 56560  
PH: 701-388-3648

**CIVIL ENGINEER**  
LOWRY ENGINEERING  
DANIELLE KUKOWSKI, P.E.  
1111 WESTRAC DR., SUITE 108  
FARGO, ND 58103  
PH: 701-235-0199

**LOWRY ENGINEERING**  
1111 WESTRAC DRIVE - SUITE 108  
FARGO, NORTH DAKOTA 58103

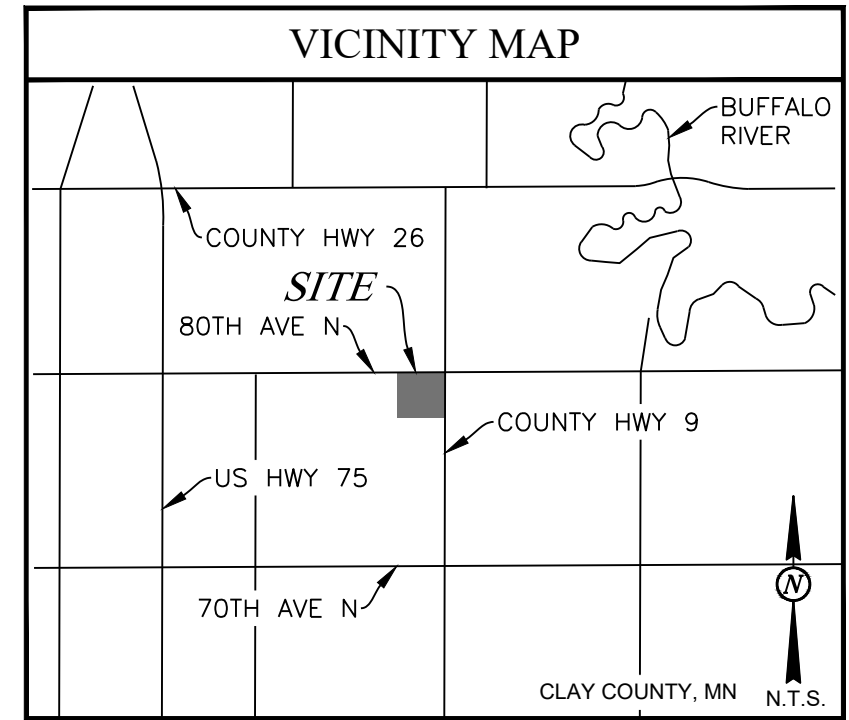

**SHEET INDEX**

C-1	OVERALL SITE PLAN
C-2	GENERAL NOTES & LEGEND
C-3	SURVEY OVERLAY & DEMOLITION PLAN
C-4	UTILITY PLAN
C-5	GRADING PLAN
C-6	PLAN & PROFILE
C-7	EROSION & SEDIMENT CONTROL PLAN
C-8	DETAILS

**ESTIMATED SITE QUANTITIES**

ITEM	QUANTITY	UNIT
NEW TREE	493	EA
NEW SIGN	2	EA

- NOTES:**
- CHANGES TO APPROVED PLANS SHALL NOT BE MADE WITHOUT OWNER'S WRITTEN APPROVAL.
  - CHANGES TO APPROVED PLANS ON PUBLIC PROPERTY SHALL NOT BE MADE WITHOUT WRITTEN APPROVAL FROM THE COUNTY.
  - LANDSCAPING IN LANDSCAPE EASEMENT AT ENTRANCE TO SUBDIVISION SHALL BE BY OWNER.
  - CONTRACTOR SHALL COORDINATE WITH OWNER ON TREE SPECIES.
  - STOP SIGN SHALL BE R1-1 30"x30". SIGN SHEETING, STRINGERS, ANCHORS, SUPPORT, AND HARDWARE SHALL MEET MNDOT STANDARD SPECIFICATIONS. BID PRICE FOR NEW STOP SIGN SHALL INCLUDE SIGN PANEL, POST, ANCHOR, BASE, HARDWARE, AND ANY OTHER ITEMS REQUIRED TO INSTALL.
  - ROAD NARROWS SIGN SHALL BE W5-1 30"x30". SIGN SHEETING, STRINGERS, ANCHORS, SUPPORT, AND HARDWARE SHALL MEET MNDOT STANDARD SPECIFICATIONS. BID PRICE FOR NEW STOP SIGN SHALL INCLUDE SIGN PANEL, POST, ANCHOR, BASE, HARDWARE, AND ANY OTHER ITEMS REQUIRED TO INSTALL.
  - SIGN LOCATION, ORIENTATION, AND HEIGHT SHALL BE PER MNDOT AND MUTCD STANDARDS.


I HEREBY CERTIFY THAT THIS PLAN, SPECIFICATION, OR REPORT WAS PREPARED BY ME OR UNDER MY DIRECT SUPERVISION AND THAT I AM A DULY LICENSED PROFESSIONAL ENGINEER UNDER THE LAWS OF THE STATE OF MINNESOTA.

*Danielle Kukowski*  
DANIELLE KUKOWSKI  
DATE: 05/13/2019  
LICENSE #: 56061

LE JOB #	18093
PROJECT DATE:	04/30/2019
CHECKED BY:	JML
DRAWN BY:	DJK
APPROVED BY:	DJK
SHEET:	1 OF 8

OVERALL  
SITE  
PLAN

**C-1**

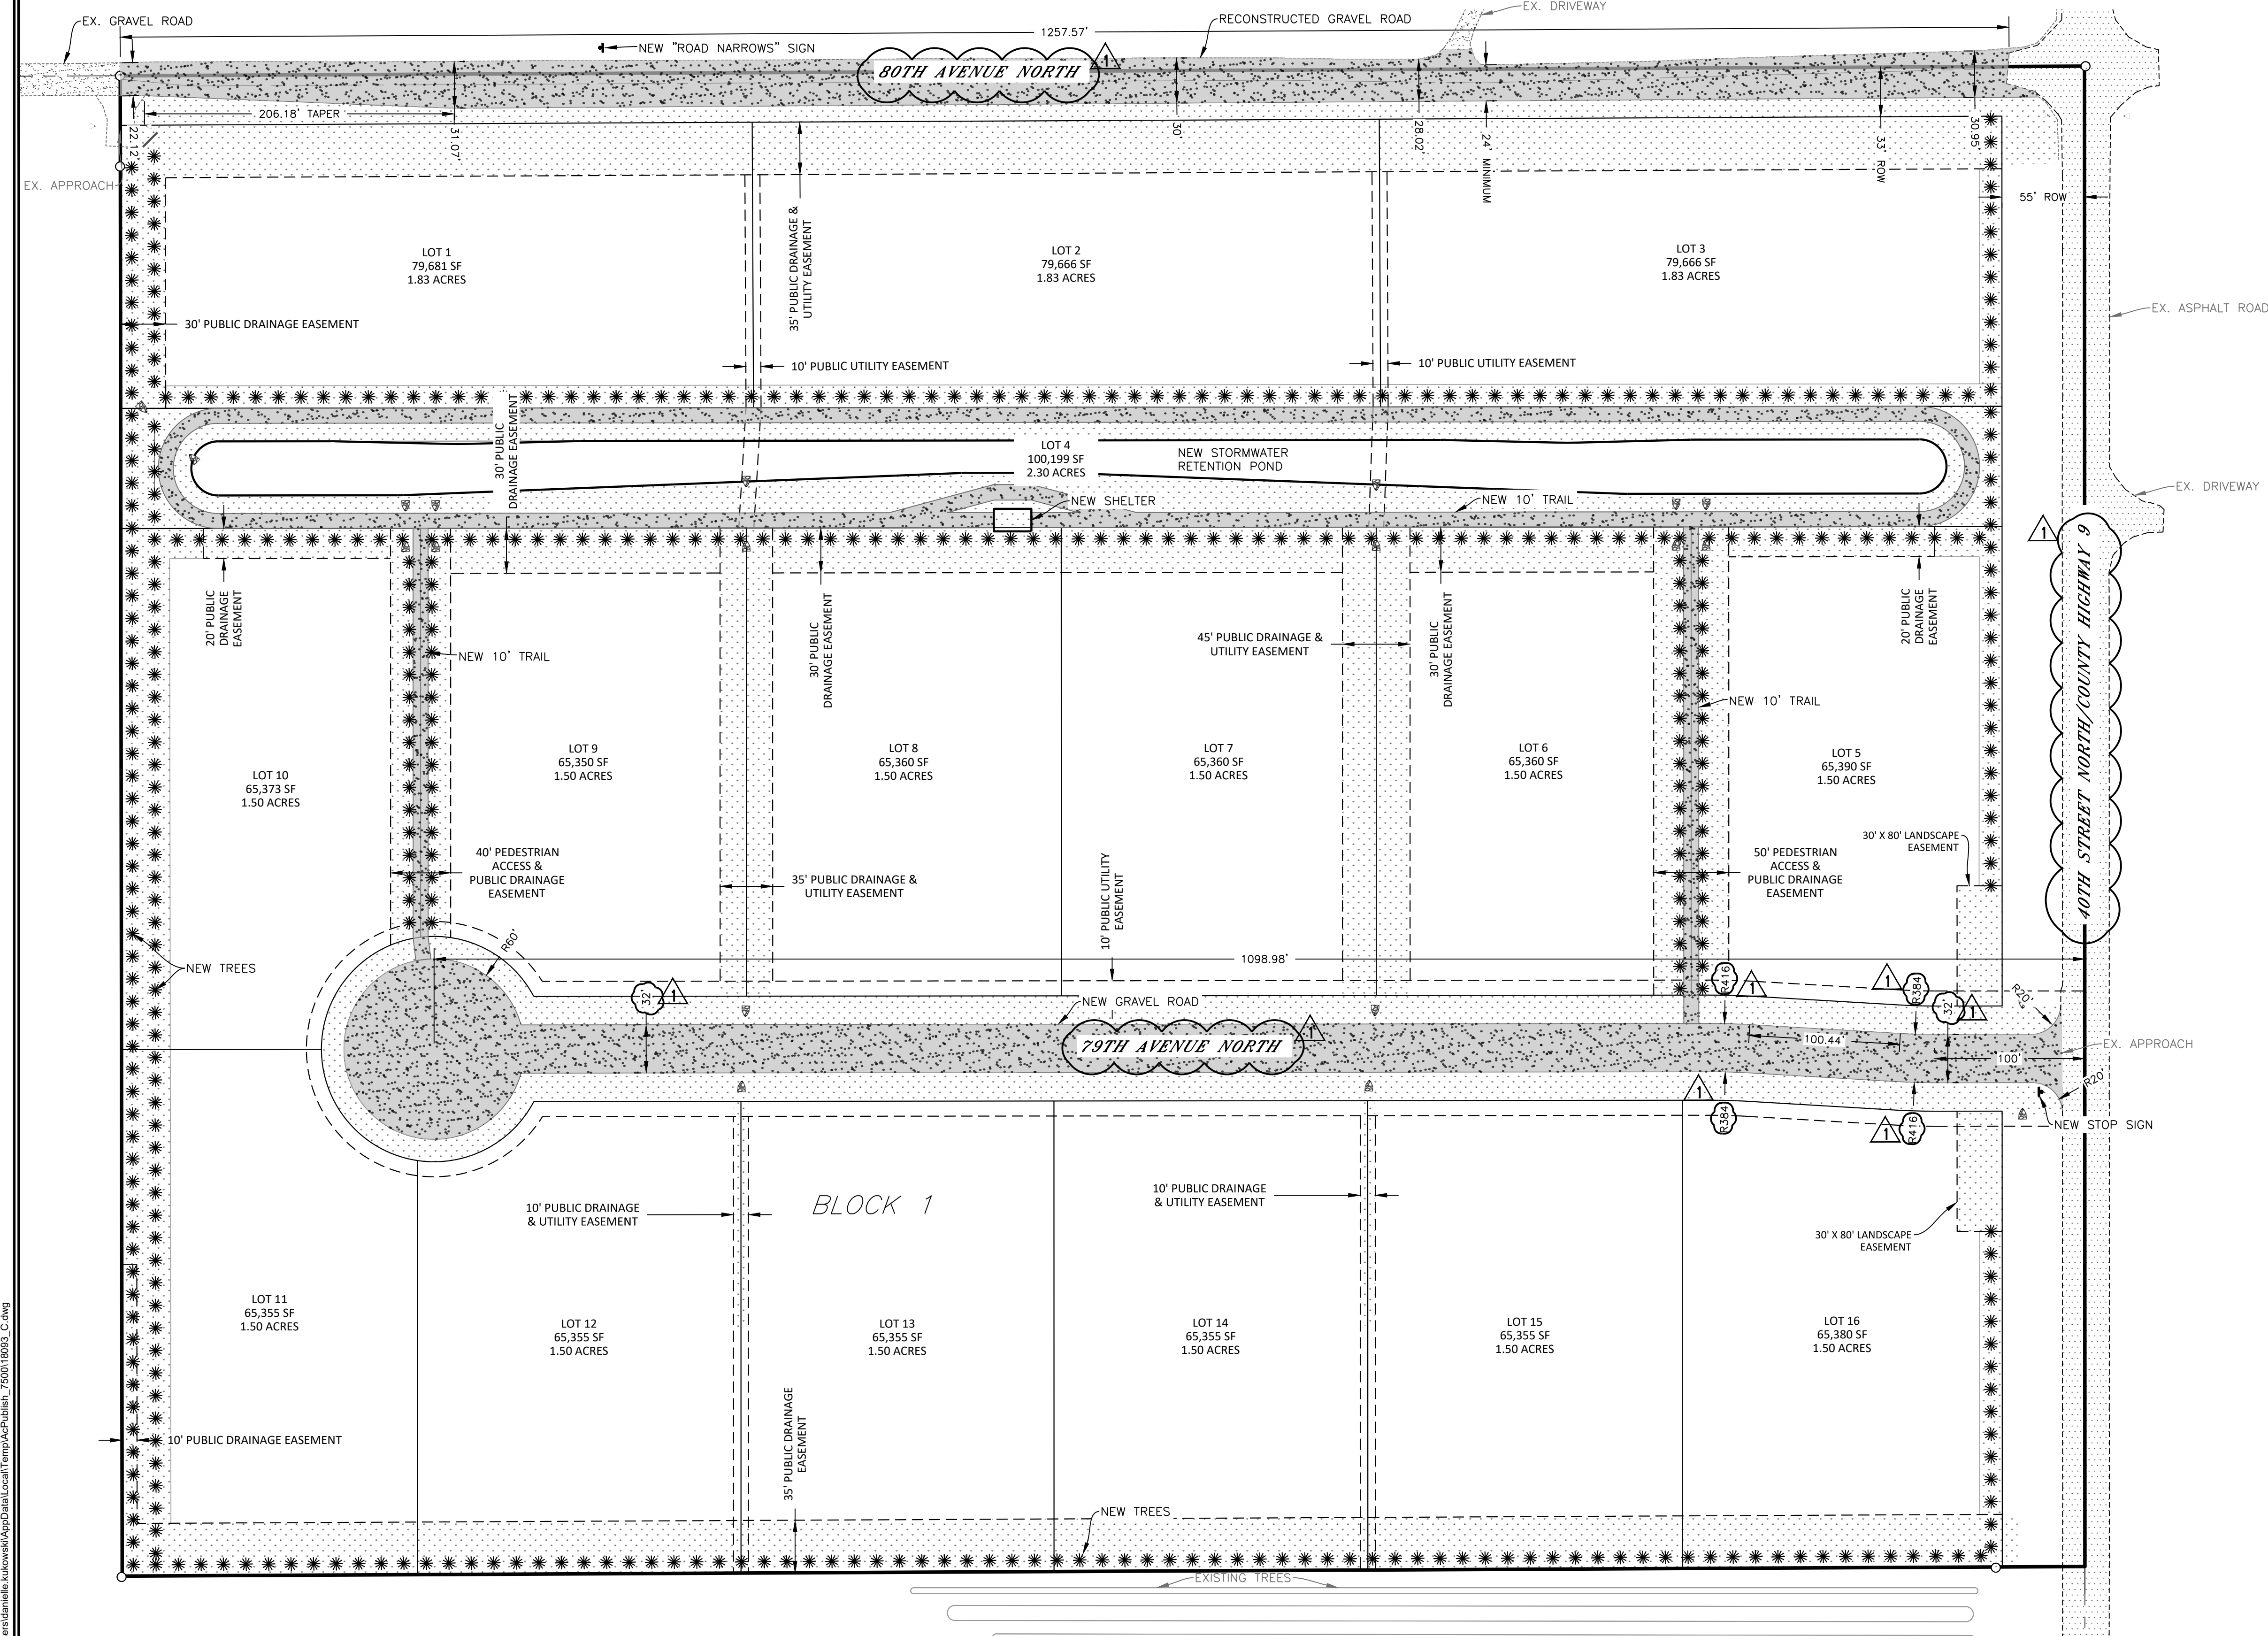

05-13-19  
• REVISED 79TH AVE TO 32' WIDE  
• ADDED MISSING ROAD LABELS

BENCHMARK: IRON PIND FOUND IN SOUTHWEST CORNER OF PROPERTY.  
ELEVATION = 897.84'. NAVD 88 DATUM

BASIS OF BEARING: CLAY COUNTY COORDINATES

**CALL BEFORE YOU DIG**  
MINNESOTA  
UTILITIES UNDERGROUND LOCATION SERVICE  
1-800-252-1166

05/13/19 02:29:53PM C:\Users\danielle.kukowski\AppData\Local\Temp\AutoPublish\_7620118093\_C.dwg

**GENERAL NOTES:**

- SHOULD THE CONTRACTOR FIND ANY DISCREPANCIES ON THE DRAWINGS, OR IN THE FIELD PRIOR TO BEGINNING WORK OR DURING CONSTRUCTION, THE CONTRACTOR SHALL IMMEDIATELY NOTIFY THE OWNER & ENGINEER.
- A COMPLETE SET OF APPROVED DRAWINGS MUST BE MAINTAINED ON SITE AT ALL TIMES BY THE GENERAL CONTRACTOR AND ALL SUBCONTRACTORS.
- CHANGES TO APPROVED PLANS SHALL NOT BE MADE WITHOUT WRITTEN APPROVAL OF THE OWNER AND ENGINEER.
- CHANGES TO APPROVED PLANS ON PUBLIC PROPERTY SHALL NOT BE MADE WITHOUT WRITTEN APPROVAL FROM THE RESPECTIVE PUBLIC ENTITY.
- ALL SITE AND RIGHT-OF-WAY CONSTRUCTION SHALL MEET CLAY COUNTY STANDARD SPECIFICATIONS LATEST REVISION. IN THE CASE OF A DISCREPANCY BETWEEN THE PLANS AND SPECIFICATIONS, THE PLANS SHALL GOVERN.
- THE CONTRACTOR IS RESPONSIBLE FOR LOCATING & VERIFYING ALL UNDERGROUND UTILITIES PRIOR TO CONSTRUCTION & IS RESPONSIBLE FOR ANY DAMAGE TO THEM DURING CONSTRUCTION. CONTRACTOR SHALL CONTACT THE LOCAL ONE-CALL SYSTEM AT LEAST 72 HOURS PRIOR TO BEGINNING CONSTRUCTION.
- ANY WORK ON EXISTING PRIVATELY OWNED UTILITIES SHALL REQUIRE NOTIFICATION TO THE RESPECTIVE ENTITY BY THE CONTRACTOR 24 HOURS PRIOR TO COMMENCING WORK.
- THE CONTRACTOR SHALL COMPLY WITH ALL RULES & REGULATIONS OF FEDERAL, STATE, COUNTY, & LOCAL AUTHORITIES.
- THE CONTRACTOR IS REQUIRED TO MEET ALL APPLICABLE FEDERAL, OSHA, STATE, AND LOCAL REGULATIONS CONCERNING PROJECT SAFETY AND ASSUMES FULL RESPONSIBILITY FOR SAFETY ON THE PROJECT.
- CONTRACTOR SHALL VERIFY THAT ALL NECESSARY PERMITS FOR CONSTRUCTION HAVE BEEN OBTAINED, ALL BONDS ARE POSTED, ALL FEES ARE PAID AND PROOF OF INSURANCE IS PROVIDED PRIOR TO THE START OF THE PROJECT.
- THE CONTRACTOR IS RESPONSIBLE FOR MAINTAINING ALL HORIZONTAL AND VERTICAL CONTROLS. THE CONTRACTOR SHALL BE RESPONSIBLE FOR ALL SURVEY AND RELATED COSTS.
- CONTRACTOR SHALL BE RESPONSIBLE FOR HIS/HER OWN MEASUREMENTS AND QUANTITIES. ENGINEER QUANTITIES ARE ESTIMATES ONLY.
- THE CONTRACTOR IS RESPONSIBLE FOR COORDINATING INSTALLATION OF UNDERGROUND UTILITIES BY THE APPROPRIATE UTILITY ENTITY. PROPER COORDINATION WITH THE RESPECTIVE UTILITY ENTITIES SHALL BE PERFORMED BY THE CONTRACTOR TO INSURE THAT ALL UTILITY ENTITY STANDARDS FOR MATERIAL AND METHODS ARE MET. THE GENERAL CONTRACTOR SHALL OVERSEE INSTALLATION OF UTILITIES AND COORDINATE WITH ALL SUBCONTRACTORS TO AVOID CONFLICTS.
- THE CONTRACTOR SHALL PROVIDE AS-BUILT RECORDS OF ALL CONSTRUCTION (INCLUDING UNDERGROUND UTILITIES) TO THE OWNER FOLLOWING COMPLETION OF CONSTRUCTION ACTIVITIES.
- THE CONTRACTOR SHALL PROVIDE TESTING, INSPECTIONS, AS-BUILT DRAWINGS, CERTIFICATIONS AND ANY OTHER PROCEDURES OR DOCUMENTATION REQUIRED BY THE GOVERNING AGENCIES TO CLOSE OUT THE PROJECT.
- THE CONTRACTOR SHALL RESTORE ANY STRUCTURES, PIPE, UTILITY, PAVEMENT, CURBS SIDEWALKS, LANDSCAPED AREAS, ETC. WITHIN THE SITE OR ADJOINING PROPERTIES DISTURBED DURING DEMOLITION OR CONSTRUCTION TO THEIR ORIGINAL CONDITION OR BETTER, AND TO THE SATISFACTION OF THE OWNER/JURISDICTIONAL AUTHORITY.
- THE CONTRACTOR IS RESPONSIBLE FOR THE REMOVAL AND DISPOSAL OF ALL STRIPPING, RUBBISH, TRASH, DEBRIS, ORGANIC, AND EXCESS EXCAVATED MATERIAL IN A LAWFUL MANNER.
- CONTRACTOR SHALL REFERENCE THE PROJECT GEOTECHNICAL REPORT AVAILABLE IN THE PROJECT MANUAL AND COMPLY WITH ALL REPORT REQUIREMENTS. IF A CONFLICT ARISES BETWEEN THE GEOTECHNICAL REPORT AND CIVIL DOCUMENTS, THE GEOTECHNICAL REPORT SHALL GOVERN.
- FOR THE PURPOSES OF CONSTRUCTION SURVEY, ALL BUILDING DIMENSIONS SHALL BE VERIFIED WITH STRUCTURAL AND ARCHITECTURAL PLANS.

**GRADING NOTES:**

- LOCATION AND TOP ELEVATIONS OF STRUCTURES MAY NEED TO BE ADJUSTED IN THE FIELD BY THE CONTRACTOR WHERE NECESSARY AND SHALL BE APPROVED BY THE ENGINEER. CONTRACTOR SHALL NOTE ANY CHANGES IN AS-BUILT DRAWINGS.
- IF UNSUITABLE SUBGRADE MATERIALS ARE ENCOUNTERED, THE CONTRACTOR IS RESPONSIBLE FOR REMOVAL AND REPLACEMENT (FROM OFF-SITE BORROW MATERIAL) OF ALL UNSUITABLE MATERIAL TO CLASSIFIED AS MH, CH, OH, OL AND PEAT IN ACCORDANCE WITH THE UNIFIED SOIL CLASSIFICATION SYSTEM, UNLESS APPROVED IN WRITING BY THE PROJECT GEOTECHNICAL ENGINEER. THE SITE ENGINEER AND GEOTECHNICAL ENGINEER SHALL BE NOTIFIED IMMEDIATELY UPON ENCOUNTERING UNSUITABLE SUBGRADE MATERIAL.
- THE CONTRACTOR IS RESPONSIBLE FOR ALL EXCAVATIONS AND GRADING INCLUDING FURNISHING OFF-SITE BORROW AND DISPOSING OF EXCESS MATERIAL AS REQUIRED TO MEET PLAN GRADES. OFF SITE BORROW SHALL MEET ALL REQUIREMENTS OF THE PROJECT GEOTECHNICAL REPORT (IF AVAILABLE) OR PER CLAY COUNTY STANDARD SPECIFICATIONS.
- COMPACTION LIFTS AND TESTING SHALL BE PER CLAY COUNTY REQUIREMENTS IN TRENCHING, SUB-BASE, BASE, AND PAVING MATERIALS. SUB-BASE LIFTS SHALL NOT EXCEED 12". BASE LIFTS SHALL NOT EXCEED 6".
- CONTRACTOR SHALL UNIFORMLY GRADE TO MATCH EXISTING GRADES AT PROPERTY LINES.
- GRADE TO ENSURE POSITIVE DRAINAGE. ALL FINISHED SURFACES SHALL BE FREE FROM SURFACE IRREGULARITIES.

**PAVING NOTES:**

- ALL PAVEMENT SECTION MATERIALS AND INSTALLATION SHALL MEET THE REQUIREMENTS OF CLAY COUNTY.
- AGGREGATE BASE COURSE SHALL MEET THE REQUIREMENTS OF MNDOT.

**STORM SEWER & DRAINAGE NOTES:**

- CMF PIPE SHALL BE SPIRAL RIB 16 GA POLYMERIC COATED OR 12 GA ALUMINIZED.
- HDPE PIPE SHALL BE ADS N12 OR PRINSCO GOLDFLO OR APPROVED EQUAL.
- INVERTS SHOWN ON PLAN DRAWINGS ARE PIPE INVERTS UNLESS NOTED OTHERWISE.
- ANY SUBSTITUTION FOR MATERIALS OR PROCEDURES MUST HAVE PRIOR WRITTEN APPROVAL OF THE COUNTY AND THE PROJECT ENGINEER.

**EROSION & SEDIMENT CONTROL / SWPPP NOTES**

- IF THE LAND BOUNDARY DENOTED ON THE PLANS ENCOMPASSES MORE THAN 1 ACRE, A NOTICE OF INTENT TO OBTAIN A STORM WATER POLLUTION CONTROL PERMIT SHALL BE ACQUIRED BY THE CONTRACTOR AND OWNER FROM THE MINNESOTA POLLUTION CONTROL AGENCY 7 DAYS PRIOR TO CONSTRUCTION. THIS NOTICE OF INTENT SHALL BE PROVIDED WITH THE BUILDING PERMIT APPLICATION. CONTRACTOR IS RESPONSIBLE FOR NOI & SWPPP SUBMITTAL.
- COPY OF NOI, COVERAGE LETTER FROM THE DOH AS WELL AS ALL MAINTENANCE AND INSPECTION RECORDS TO BE KEPT ON SITE AND AVAILABLE FOR REVIEW BY CITY, STATE OR FEDERAL OFFICIALS UPON REQUEST.
- CONTRACTOR SHALL HAVE AN UPDATED SWPPP AVAILABLE ON SITE ANYTIME WORK IS BEING DONE. THIS DOCUMENT SHALL BE AVAILABLE FOR REVIEW BY CITY, STATE OR FEDERAL OFFICIALS UPON REQUEST. THE SWPPP SHALL BE IN ACCORDANCE WITH THE MINNESOTA GENERAL PERMIT NO. MNR100001 AND THE PLANS. THE ESC PLAN IS THE ENGINEER'S RECOMMENDATION FOR EROSION AND SEDIMENT CONTROL BASED ON THE DESIGN OF THE PROPOSED SITE. THIS DESIGN DOES NOT TAKE INTO EFFECT CONTRACTOR MEANS AND METHODS, CONSTRUCTION SCHEDULE, OR ORDER OF OPERATIONS. CONTRACTOR IS EXPECTED TO ADJUST DESIGN AS IS NECESSARY TO MEET THE REQUIREMENTS OF THE GENERAL PERMIT. CONTRACTOR IS RESPONSIBLE FOR ALL EROSION AND SEDIMENT CONTROL ON THE SITE. THIS INCLUDES BUT IS NOT LIMITED TO STORM WATER EROSION, EROSION FROM PUMPING OPERATIONS, OFF SITE TRACKING, DUST CONTROL AND CONTROL OF ANY CONCRETE GRINDINGS OR SAW CUT DUST. CONTRACTOR IS ALSO RESPONSIBLE FOR ALL OTHER ITEMS AS REQUIRED IN THE GENERAL PERMIT.
- INSPECTIONS SHALL BE DONE AND DOCUMENTED BY THE CONTRACTOR EVERY 14 DAYS AND AFTER A RAIN EVENT 1/4" OR GREATER. A RAIN GAUGE SHALL BE ONSITE AND USED TO MAKE THIS DETERMINATION.
- SITE SHALL BE STABILIZED WITHIN 14 DAYS OF COMPLETION OF WORK OR WITHIN 14 DAYS OF SUSPENSION OF WORK PER THE GENERAL PERMIT.
- ALL EROSION AND SEDIMENT RELATED CONTROL AND ITEMS NEED TO BE INSTALLED AND MAINTAINED IN ACCORDANCE WITH MANUFACTURERS RECOMMENDATIONS UNLESS OTHERWISE DICTATED IN THE PLANS.
- CONTRACTOR IS RESPONSIBLE FOR ALL DE-WATERING AS NECESSARY TO MEET REQUIRED EXCAVATIONS AND GRADES. MUDDY WATER TO BE PUMPED FROM EXCAVATION AND WORK AREAS MUST BE HELD IN SETTLING BASINS OR FILTERED PRIOR TO ITS DISCHARGE INTO SURFACE WATERS OR STORM DRAINAGE SYSTEMS. WATER MUST BE DISCHARGED THROUGH A PIPE, WELL GRASSED OR LINED CHANNEL, OR OTHER EQUIVALENT MEANS SUCH THAT DISCHARGE DOES NOT CAUSE EROSION OR SEDIMENTATION. THIS INCLUDES DE-WATERING OF RAINWATER, GROUND WATER, OR ANY OTHER WATER ON SITE CAUSING IMPACTS TO SITE CONSTRUCTION.
- ALL DISTURBED AREAS SHALL BE SEEDED AND HYDROMULCHED UNLESS SHOWN OTHERWISE IN THE PLANS.
- TOP SOIL OR OTHER SOIL/CLAY STOCKPILES ARE NOT TO BE LOCATED WITHIN FLOW PATHS, BASES OF ALL STOCKPILES SHALL BE SURROUNDED WITH SILT FENCE.

**SEEDING NOTES:**

- ALL SEEDING MIX SHALL CONSIST OF THE FOLLOWING:
  - PERENNIAL RYEGRASS = 50 LBS OF LIVE SEED PER ACRE
  - PARK KENTUCKY BLUEGRASS = 50 LBS OF LIVE SEED PER ACRE
  - DURAHARD FESCUE = 30 LBS OF LIVE SEED PER ACRE
  - TOTAL LBS PER ACRE = 130
  - FERTILIZER TYPE = 5-10-5
  - FERTILIZER APPLICATION RATE = 50 LBS PER ACRE
- CULTIVATE OR DISK TOPSOIL TO A DEPTH OF APPROXIMATELY 3".
- REMOVE MATERIALS GREATER THAN 1" IN DIAMETER THAT CANNOT BE BROKEN UP.
- PLANT SEEDS TO A DEPTH BETWEEN 1/4" AND 3/8".
- SEED ONLY WHEN WIND IS LESS THAN 15 MPH WHEN NOT USING A GRASS DRILL.
- MULCHING SHALL BE USED IMMEDIATELY AFTER SEEDING TO PREVENT EROSION AND PROMOTE EARLIER VEGETATION COVER.
- CONTRACTOR IS RESPONSIBLE FOR WATERING TO ESTABLISH GRASS GROWTH TO A HEIGHT OF 3".

**TEMPORARY TRAFFIC CONTROL NOTES:**

- UNLESS NOTED OTHERWISE, THE CONTRACTOR SHALL BE RESPONSIBLE TO PROVIDE AN ATSSA CERTIFIED TRAFFIC CONTROL SUPERVISOR (TCS) AND ANY NECESSARY TEMPORARY TRAFFIC CONTROL DEVICES ON AND OFF-SITE INCLUDING OBTAINING ANY APPLICABLE PERMITS. THE CONTRACTOR SHALL IDENTIFY THE TCS AND PROVIDE PROOF OF CERTIFICATION AT A PRECONSTRUCTION MEETING.
- UNLESS A TEMPORARY TRAFFIC CONTROL PLAN IS INCLUDED WITH THE DESIGN DOCUMENTS, CONTRACTOR SHALL SUBMIT A COPY OF THE APPROVED TRAFFIC CONTROL PLAN TO THE ENGINEER FOR REVIEW.
- CONTRACTOR IS RESPONSIBLE TO INSTALL, INSPECT, MAINTAIN, AND REMOVE TRAFFIC CONTROL DEVICES IN ACCORDANCE WITH THE LATEST STANDARDS AND REQUIREMENTS OF THE MUTCD, STANDARD HIGHWAY SIGNS AND MARKINGS BOOK PUBLISHED BY THE FHWA, AND LOCAL REGULATIONS.
- CHANGES TO THE TEMPORARY TRAFFIC CONTROL PLAN SHALL NOT BE MADE WITHOUT WRITTEN APPROVAL OF THE OWNER, ENGINEER, AND PERMITTING AUTHORITY IF APPLICABLE.

**LEGEND**

	EX. LIGHT POLE		BORING LOCATION		EX. FIBER OPTIC
	NEW LIGHT POLE		EX. SIGN		EX. GAS LINE
	EX. POWER POLE		NEW SIGN		EX. OVERHEAD ELECTRIC
	NEW GREASE TRAP		NEW PROPERTY PIN SET		EX. CABLE TV
	NEW CLEAN OUT		EX. PROPERTY PIN FOUND RIGHT OF WAY MARKER		EX. TELEPHONE
	EX. SANITARY MANHOLE		HIGH WATER LINE		EX. CONTOUR 2452
	NEW SANITARY MANHOLE		PARKING COUNT		EX. CONTOUR 2455
	EX. STORM MANHOLE		DOWN SPOUT		CENTER LINE/SECTION LINE
	NEW STORM MANHOLE		EXPANSION JOINT		GRADE BREAK/DRAINAGE AREAS
	EX. STORM CATCH BASIN		EX. FENCE		NEW TRACKS
	NEW STORM CATCH BASIN		NEW FENCE		EX. ASPHALT PAVEMENT
	EX. CULVERT FLARE END		EX. GUARDRAIL		NEW ASPHALT PAVEMENT
	NEW CULVERT FLARE END		SET BACK		EX. CONCRETE PAVEMENT
	EX. HEADWALL		EX. EASEMENT		NEW CONCRETE PAVEMENT
	NEW HEADWALL		NEW EASEMENT		EX. GRAVEL SURFACE
	EX. GATE VALVE		EX. PROPERTY LINE		NEW GRAVEL SURFACE
	NEW GATE VALVE		NEW ROW/PROPERTY LINE		EX. SIDEWALK/FLATWORK
	EX. WATERLINE FITTINGS		PROPERTY BOUNDARY LINE		NEW SIDEWALK/FLATWORK
	NEW WATERLINE FITTINGS		EX. CURB		ACCESSIBLE (ADA) RAMP
	NEW TAPPING SLEEVE & VALVE		NEW CURB(INFLOW)		STRIPING CROSSWALK
	EX. HYDRANT		NEW CURB(OUTFLOW)		STRIPING ADA ACCESSIBLE
	NEW HYDRANT & VALVE		EX. RETAINING WALL		STRIPING TURN ARROWS
	EX. STUMP		NEW RETAINING WALL		SEEDING & HYDROMULCH
	EX. SHRUB		EX. SANITARY SEWER		
	EX. DECIDUOUS TREE		NEW SANITARY SEWER		
	EX. CONIFEROUS TREE		EX. SANITARY FORCE MAIN		
	NEW SHRUB		NEW SANITARY FORCE MAIN		
	NEW CONIFEROUS TREE		EX. WATER		
	EX. ELECTRICAL TRANSFORMER		NEW WATER		
	EX. TELEPHONE PEDISTAL		EX. STORM SEWER		
	EX. ELECTRICAL OUTLET		NEW STORM SEWER		
	EX. UTILITY PEDISTAL		EX. DRAIN TILE		
	ELEC MANHOLE EXIST		NEW DRAIN TILE		
			EX. STORM FORCE MAIN		
			NEW STORM FORCE MAIN		

**ABBREVIATIONS**

ADJ	ADJACENT	ELEV	ELEVATION	P.C.	PRECAST CONCRETE
ALT	ALTERNATE	ENCL	ENCLOSURE	PVIE	POINT OF VERTICAL INTERSECTION ELEVATION
ARCH	ARCHITECT	E.O.P.	END OF PROJECT	PVIS	POINT OF VERTICAL INTERSECTION STATION
ACP	ASBESTOS CEMENT PIPE	E.J.	EXPANSION JOINT	PREFAB	PREFABRICATED
BIT	BITUMINOUS	EX.	EXISTING	PSI	POUNDS PER SQUARE INCH
BLDG	BUILDING	E.X.A.	EACH WAY	PVC	POLYVINYL CHLORIDE PIPE
BM	BENCHMARK	EVCE	END VERTICAL CURVE ELEVATION	PP	POWER POLE
B.O.	BY OWNER/BY OTHERS	EVCS	END VERTICAL CURVE STATION	R	RADIUS
B.O.P.	BEGINNING OF PROJECT	FD	FIRE DEPARTMENT	RCP	REINFORCED CONCRETE PIPE
BV	BUTTERFLY VALVE	FFE	FIRST FLOOR ELEVATION	RD	ROOF DRAIN
BVCE	BEGINNING VERTICAL CURVE ELEVATION	FO	FIBER OPTICS	REQ'D	REQUIRED
BVCS	BEGINNING VERTICAL CURVE STATION	FTG	FOOTING	RIM	RIM OF INLET OR CASTING
C	CIVIL	G.C.	GENERAL CONTRACTOR	ROW	RIGHT OF WAY
B.P.	CAST IRON	GALV	GALVANIZED	SAN	SANITARY
CIP	CAST IRON PIPE	GRAN	GRANULAR	SS	SANITARY SEWER
CU	COPPER	GV	GATE VALVE	STD	STORM
CMP	CORRUGATED METAL PIPE	HDPE	HIGH DENSITY POLYETHYLENE	ST	STANDARD
CJ	CONTROL JOINT	HORZ	HORIZONTAL	SB	SOIL BORING
CONC	CONCRETE	HB	HOSE BIB	STRUCT	STRUCTURAL
CF	CUBIC FEET	HDCP	HANDICAPPED	SF	SQUARE FEET
CS	CURB STOP	HYD	HYDRANT	SCH	SCHEDULE
C.O.	CLEAN OUT	I	INLET	SW	SIDEWALK
CNTR	CENTER	K	CURVATURE VALUE	T	TELEPHONE
CONST	CONSTRUCTION	M	MECHANICAL	TYP	TYPICAL
CONTR	CONTRACTOR	MH	MANHOLE	UNEX	UN-EXCAVATED
CY	CUBIC YARD	MAX	MAXIMUM	UE	UTILITY EASEMENT
DIA	DIAMETER	MIN	MINIMUM	UGE	UNDERGROUND ELECTRIC
DIP	DUCTILE IRON PIPE	M.J.	MECHANICAL JOINT	UNO	UNLESS NOTED OTHERWISE
DEMO	DEMOLITION	MISC.	MISCELLANEOUS	VERT	VERTICAL
DTL	DETAIL	NC	NON-CORROSIVE	V	VERIFY
DIM	DIMENSION	NOM	NOMINAL	VCL	VERTICAL CURVE LENGTH
DOM	DOMESTIC	NIC	NOT IN CONTRACT	VOL	VOLUME
D.S.	DOWN SPOUT	NTS	NOT TO SCALE	VCP	VITRIFIED CLAY PIPE
DWG	DRAWING	OD	OUTSIDE DIMENSION	W	WIDTH
DWL	DOWEL	OCEW	ON CENTER EACH WAY	W/O	WITH OUT
EA	EACH	OC	ON CENTER	WTH	WITH
ELEC	ELECTRIC	OHE	OVERHEAD ELECTRIC	W	WATER

**LOWRY**  
ENGINEERING  
1111 WESTRAC DRIVE - SUITE 108  
FARGO, NORTH DAKOTA 58103

**REVISIONS**


**LINDEN TRAILS SUBDIVISION  
S10-T140N-R48W  
CLAY COUNTY, MINNESOTA**

I HEREBY CERTIFY THAT THIS PLAN, SPECIFICATION, OR REPORT WAS PREPARED BY ME OR UNDER MY DIRECT SUPERVISION AND THAT I AM A DULY LICENSED PROFESSIONAL ENGINEER UNDER THE LAWS OF THE STATE OF MINNESOTA.

*Danielle Kukowski*  
DANIELLE KUKOWSKI  
DATE: 04/30/2019  
LICENSE #: 56061

LE JOB #	18093
PROJECT DATE:	04/30/2019
CHECKED BY:	JML
DRAWN BY:	DJK
APPROVED BY:	DJK
SHEET:	2 OF 8



GENERAL NOTES & LEGEND

**C-2**







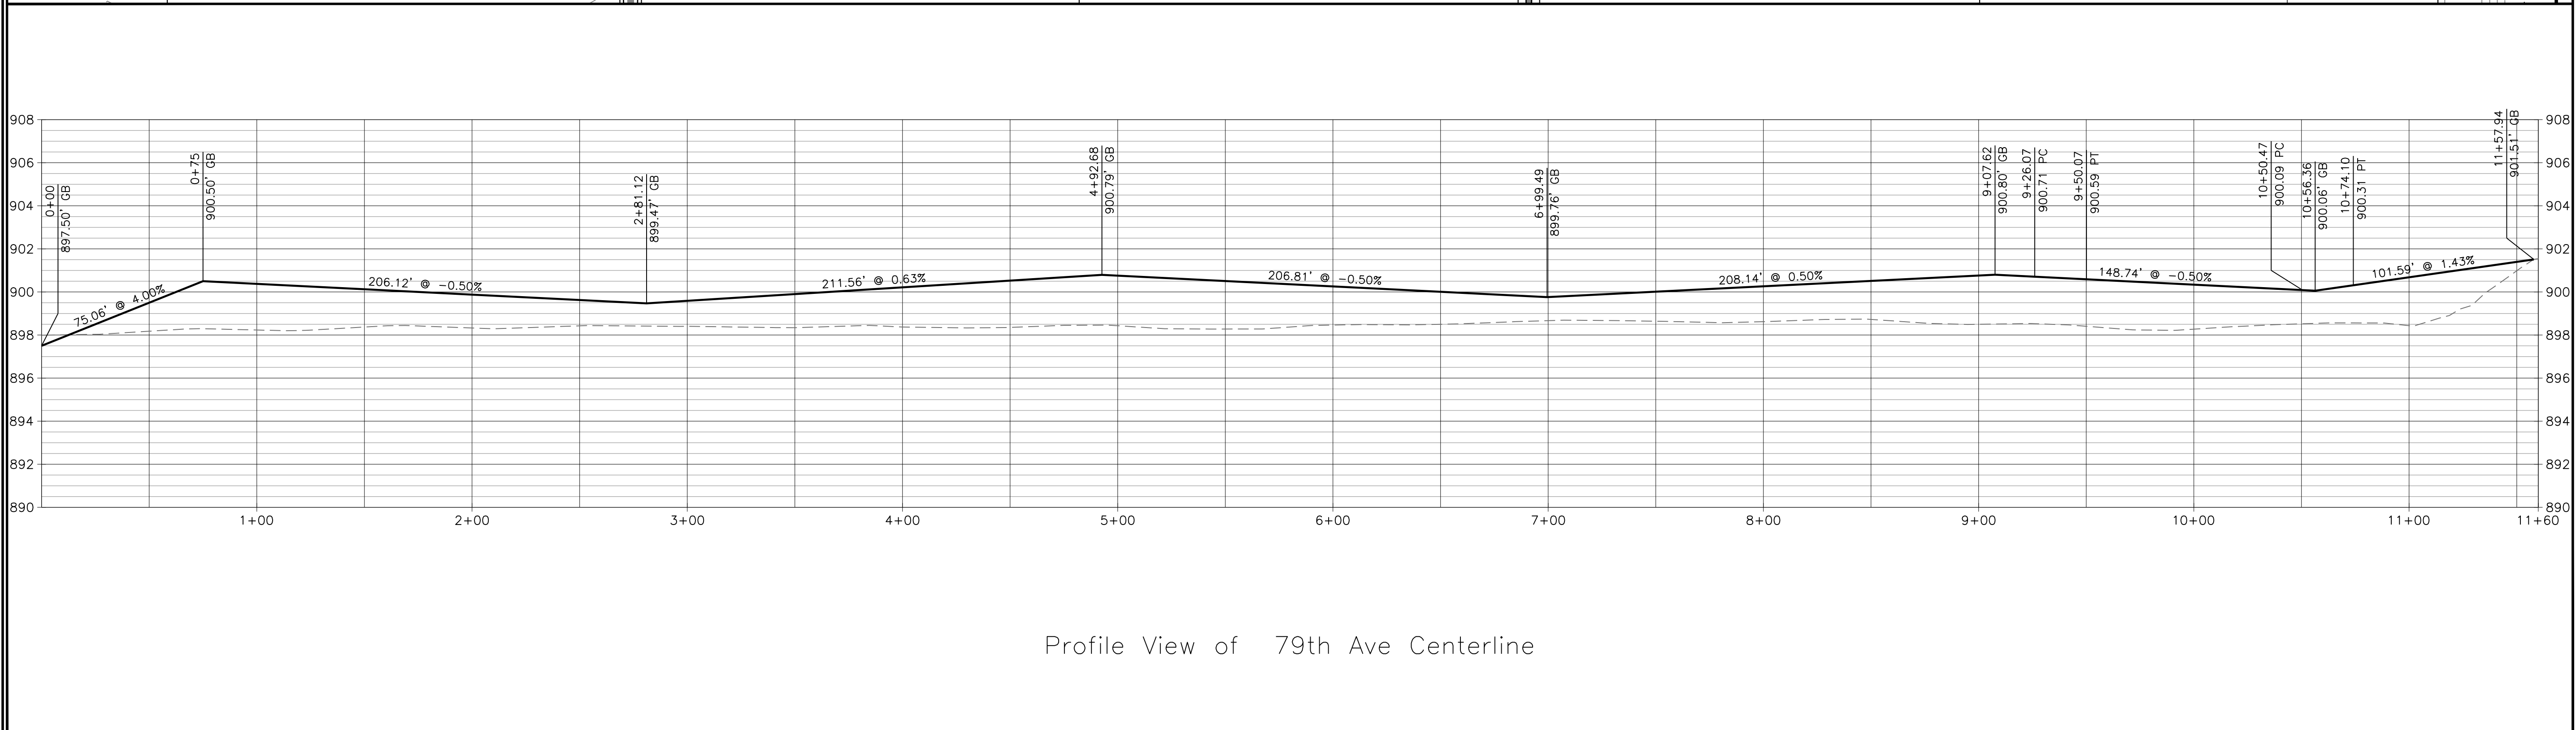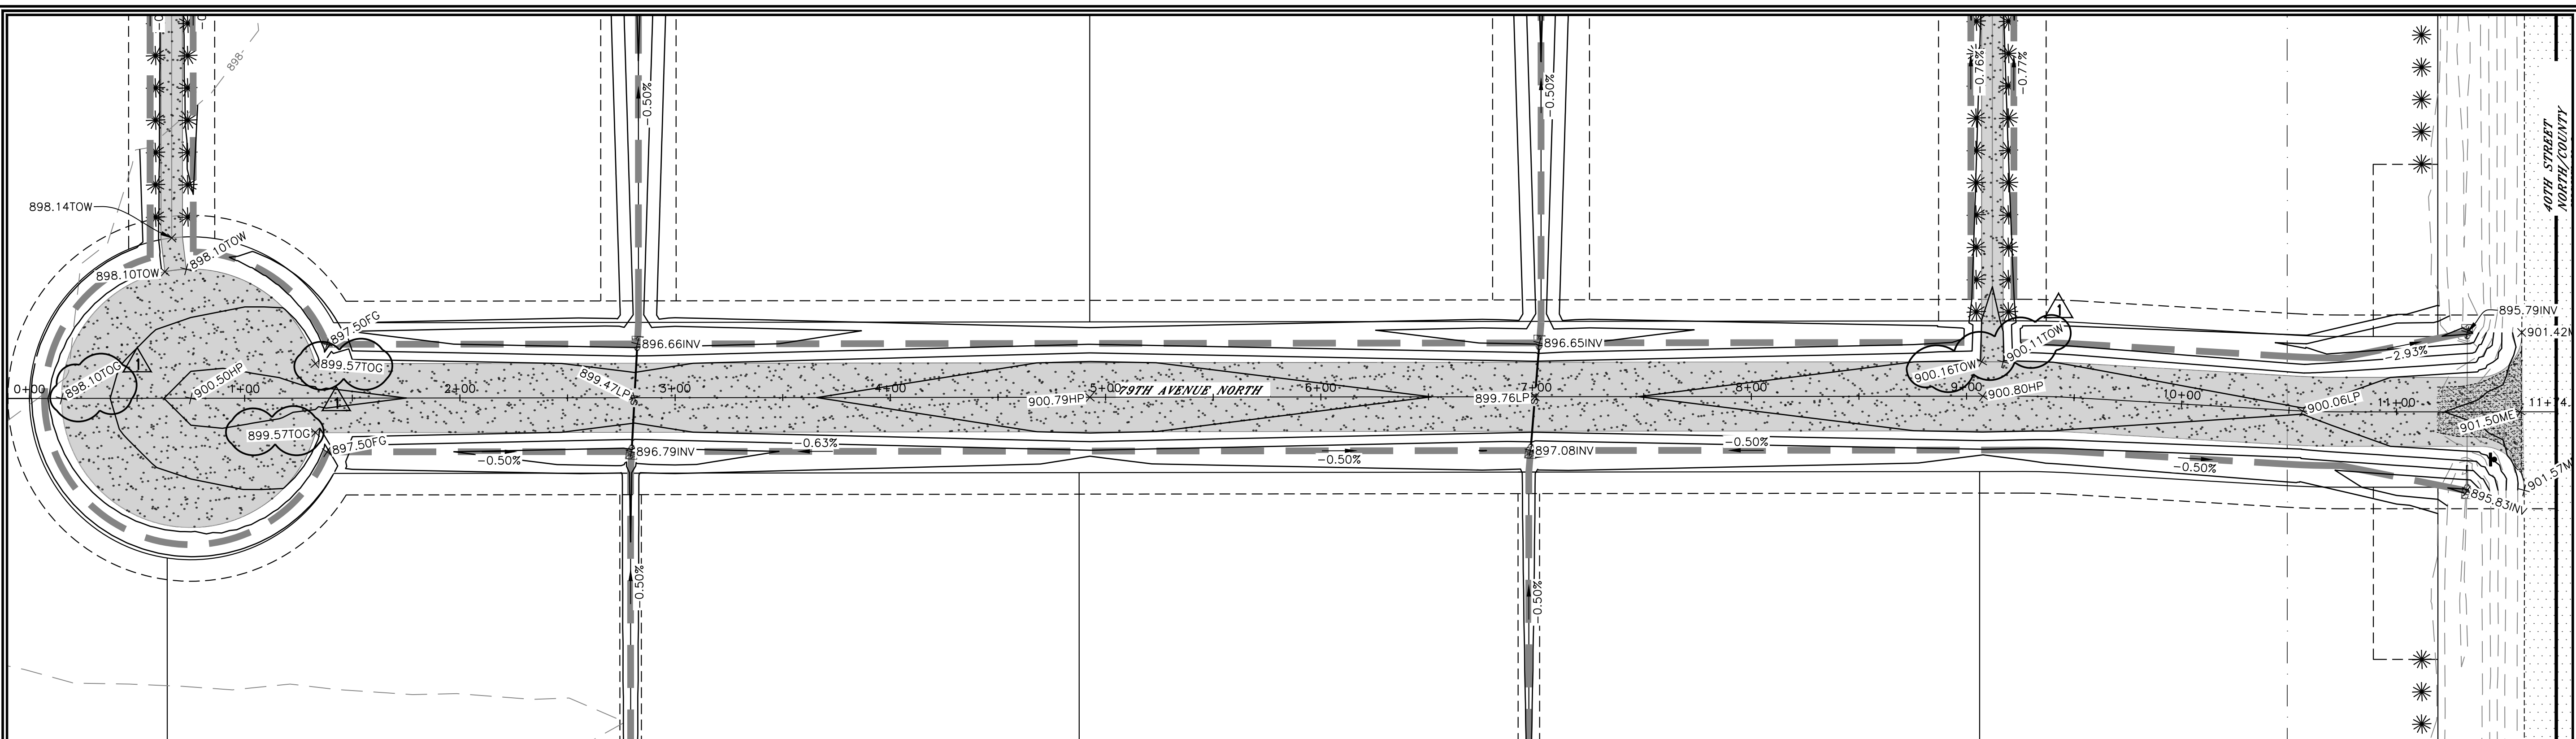

Profile View of 79th Ave Centerline

REVISIONS

05-13-19	- COUNTY COMMENTS
----------	-------------------


**LINDEN TRAILS SUBDIVISION  
S10-T140N-R48W  
CLAY COUNTY, MINNESOTA**

I HEREBY CERTIFY THAT THIS PLAN, SPECIFICATION, OR REPORT WAS PREPARED BY ME OR UNDER MY DIRECT SUPERVISION AND THAT I AM A DULY LICENSED PROFESSIONAL ENGINEER UNDER THE LAWS OF THE STATE OF MINNESOTA.

*Danielle Kukowski*  
DANIELLE KUKOWSKI  
DATE: 05/13/2019  
LICENSE #: 56061

LE JOB #	18093
PROJECT DATE:	04/30/2019
CHECKED BY:	JML
DRAWN BY:	DJK
APPROVED BY:	DJK
SHEET:	6 OF 8

05-13-19  
• REVISED GRADING CALL OUTS FOR 32' WIDE

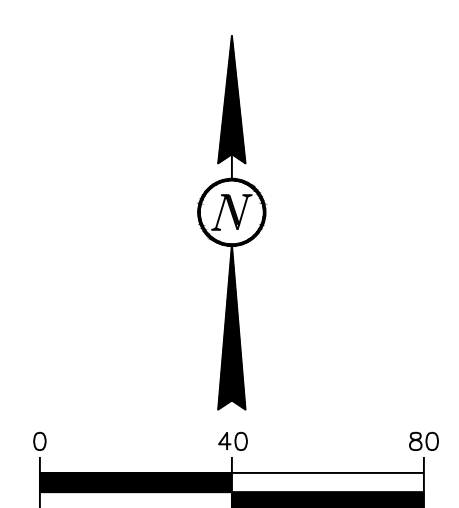


**CALL BEFORE YOU DIG**  
MINNESOTA  
UTILITIES UNDERGROUND LOCATION SERVICE  
1-800-252-1166

PLAN & PROFILE

**C-6**

C:\Users\danielle.kukowski\AppData\Local\Temp\AutoPublish\_Z50016893\_C.dwg

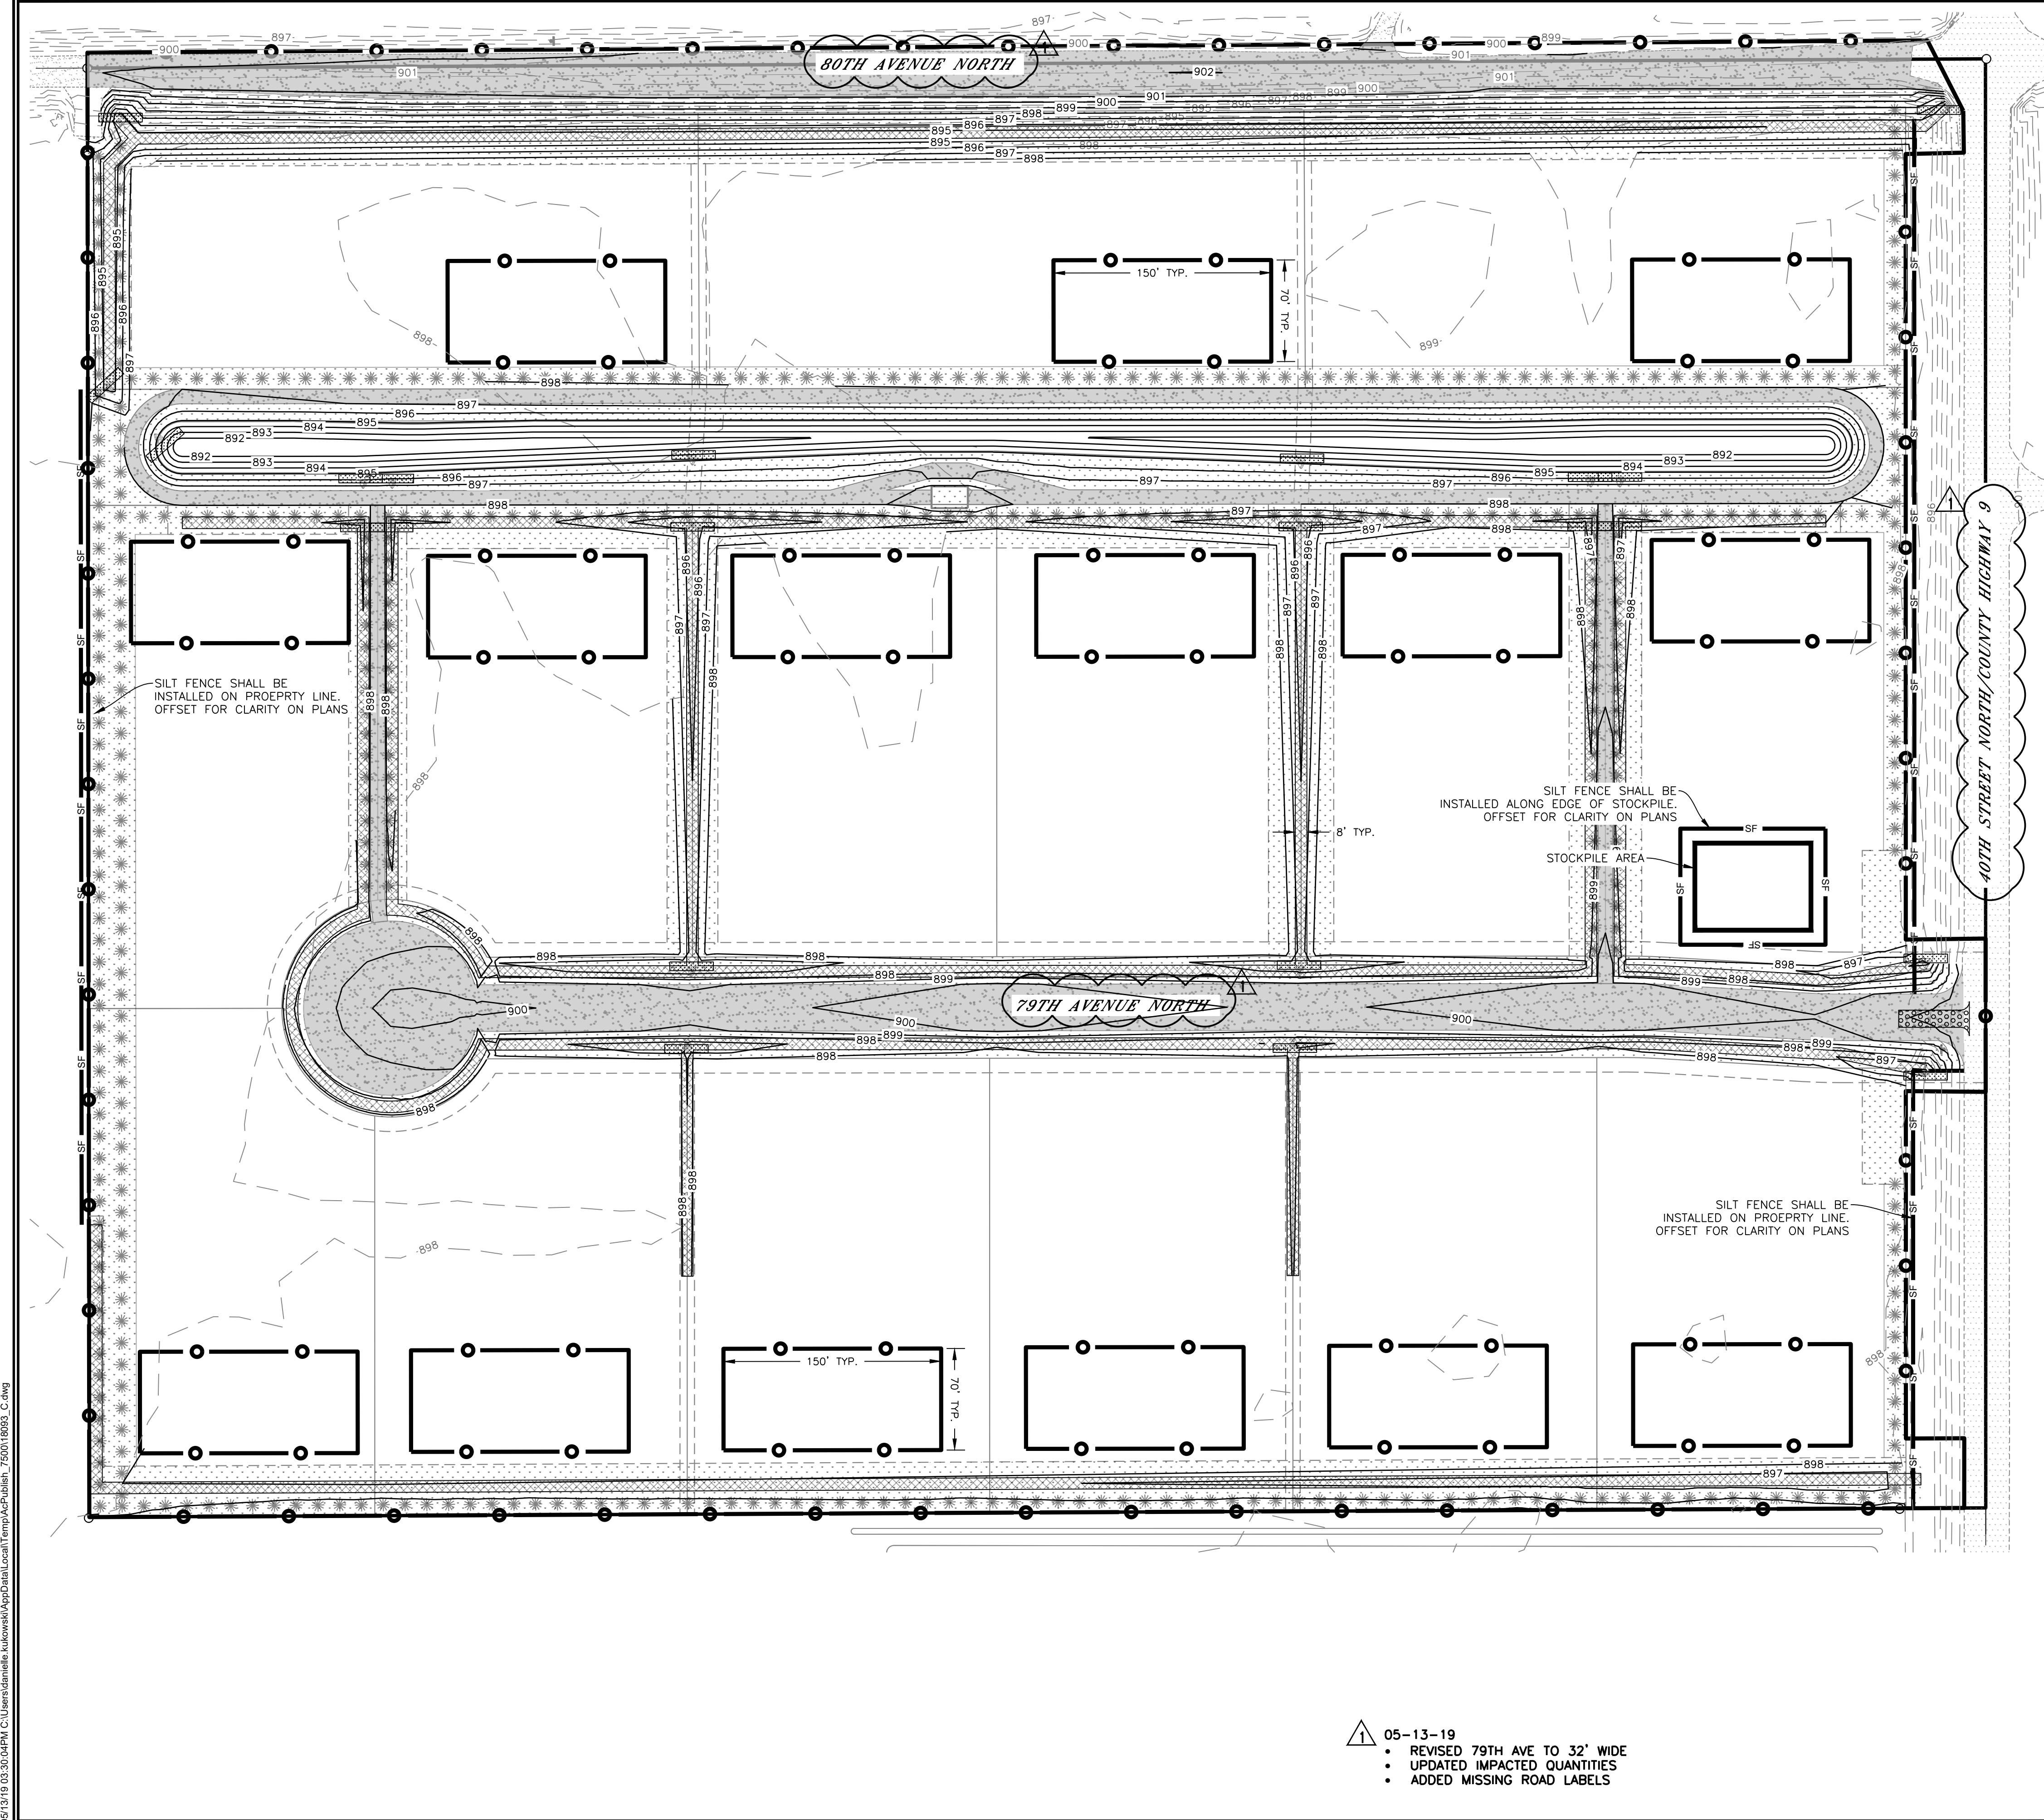

EROSION CONTROL LEGEND			
	LIMITS OF CONSTRUCTION		
	SILT FENCE	1,879	LF
	FIBER ROLL PROTECTION (STRAW WATTLE)	216	LF
	SEEDING & HYDROMULCH	35,772	SY
	EROSION CONTROL BLANKET	7,448	SY
	VEHICLE TRACKING PAD	1	EA

- NOTES:
- CONTRACTOR SHALL FOLLOW MPCA STORMWATER POLLUTION PREVENTION STANDARDS FOR ALL EROSION CONTROL DURING CONSTRUCTION.
  - CONTRACTOR SHALL SEED & MULCH ALL DISTURBED AREAS WITHIN 14 DAYS.
  - CONTRACTOR SHALL INSTALL STRAW WATTLE AROUND FLARED END SECTIONS UNTIL RIP-RAP IS INSTALLED AND SITE IS STABILIZED.

**LOWRY**  
ENGINEERING  
1111 WESTRAC DRIVE - SUITE 108  
FARGO, NORTH DAKOTA 58103

REVISIONS	COUNTY COMMENTS
05-13-19	

**LINDEN TRAILS SUBDIVISION  
S10-T140N-R48W  
CLAY COUNTY, MINNESOTA**

I HEREBY CERTIFY THAT THIS PLAN, SPECIFICATION, OR REPORT WAS PREPARED BY ME OR UNDER MY DIRECT SUPERVISION AND THAT I AM A DULY LICENSED PROFESSIONAL ENGINEER UNDER THE LAWS OF THE STATE OF MINNESOTA.

*Danielle Kukowski*  
DANIELLE KUKOWSKI  
DATE: 05/13/2019  
LICENSE #: 56061

LE JOB #	18093
PROJECT DATE:	04/30/2019
CHECKED BY:	JML
DRAWN BY:	DJK
APPROVED BY:	DJK
SHEET:	7 OF 8

EROSION & SEDIMENT CONTROL PLAN

**C-7**


- 05-13-19
- REVISED 79TH AVE TO 32' WIDE
  - UPDATED IMPACTED QUANTITIES
  - ADDED MISSING ROAD LABELS

CALL BEFORE YOU DIG  
MINNESOTA  
UTILITIES UNDERGROUND LOCATION SERVICE  
1-800-252-1166


C:\Users\danielle.kukowski\AppData\Local\Temp\AutoPublish\_7620116293\_C.dwg

I HEREBY CERTIFY THAT THIS PLAN, SPECIFICATION, OR REPORT WAS PREPARED BY ME OR UNDER MY DIRECT SUPERVISION AND THAT I AM A DULY LICENSED PROFESSIONAL ENGINEER UNDER THE LAWS OF THE STATE OF MINNESOTA.  
*Danielle Kukowski*  
DANIELLE KUKOWSKI  
DATE: 05/13/2019  
LICENSE #: 56061

LE JOB #	18093
PROJECT DATE:	04/30/2019
CHECKED BY:	JML
DRAWN BY:	DJK
APPROVED BY:	DJK
SHEET:	8 OF 8

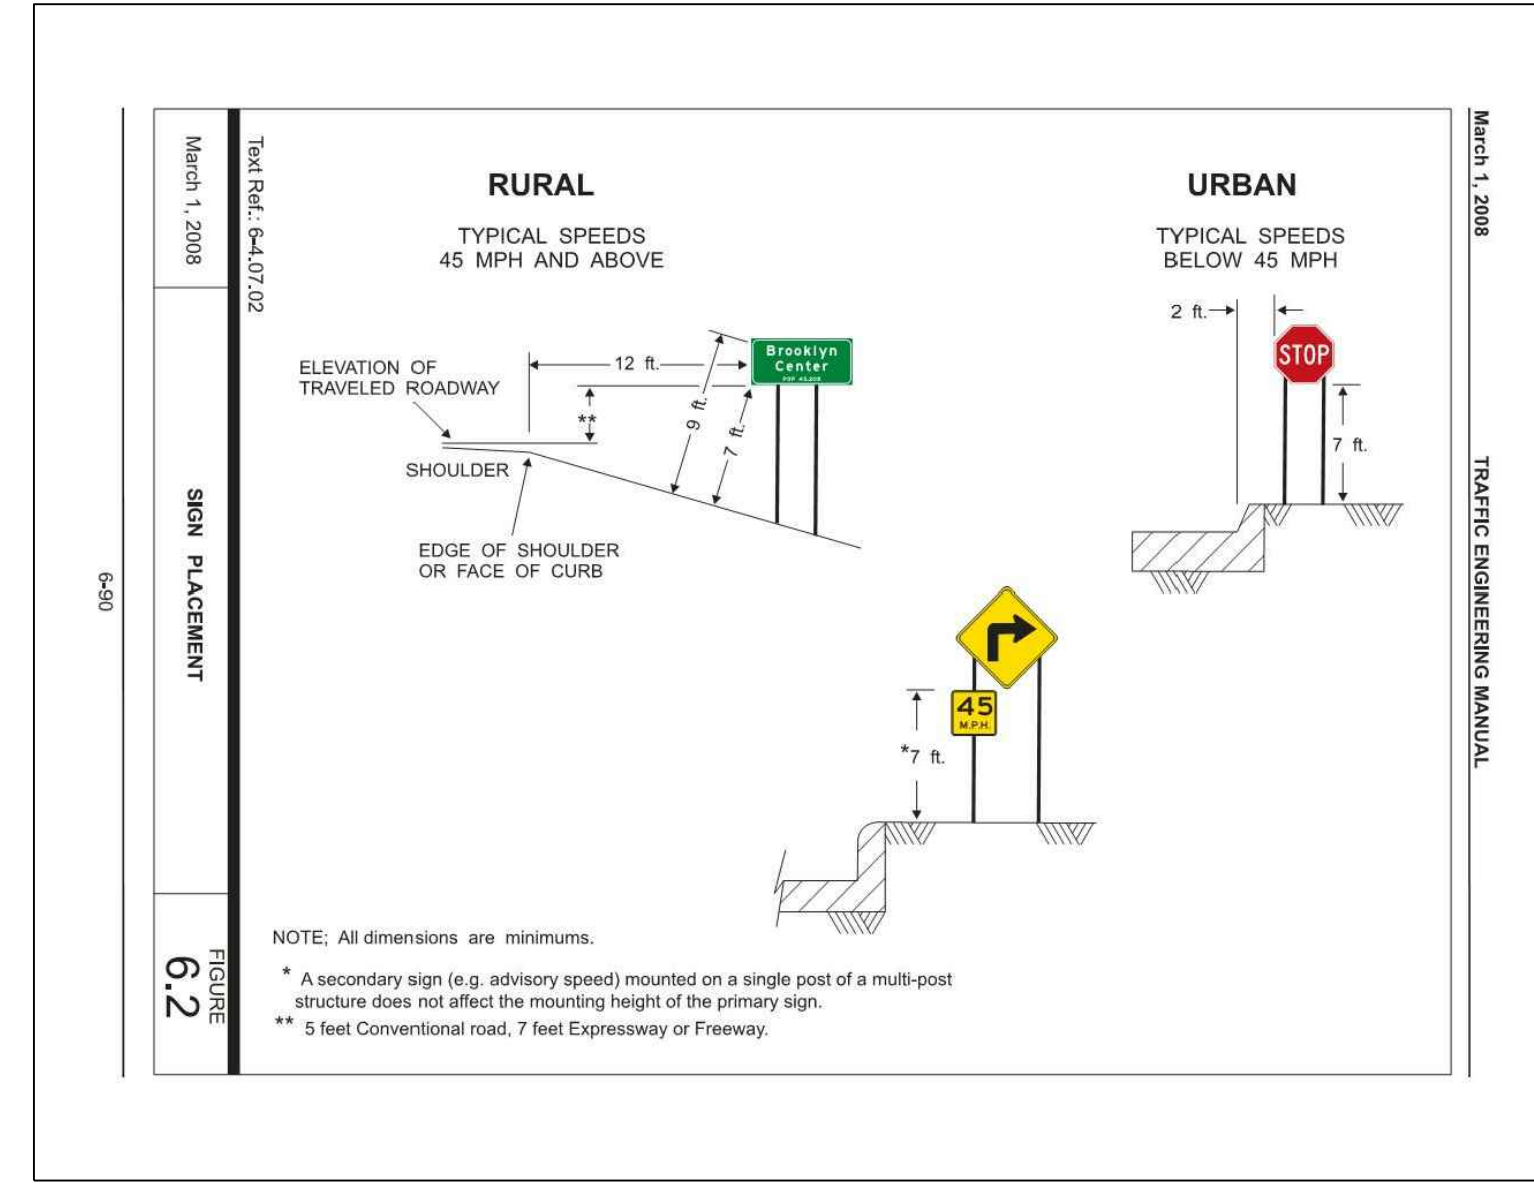


4 STOP SIGN PLACEMENT  
N.T.S.

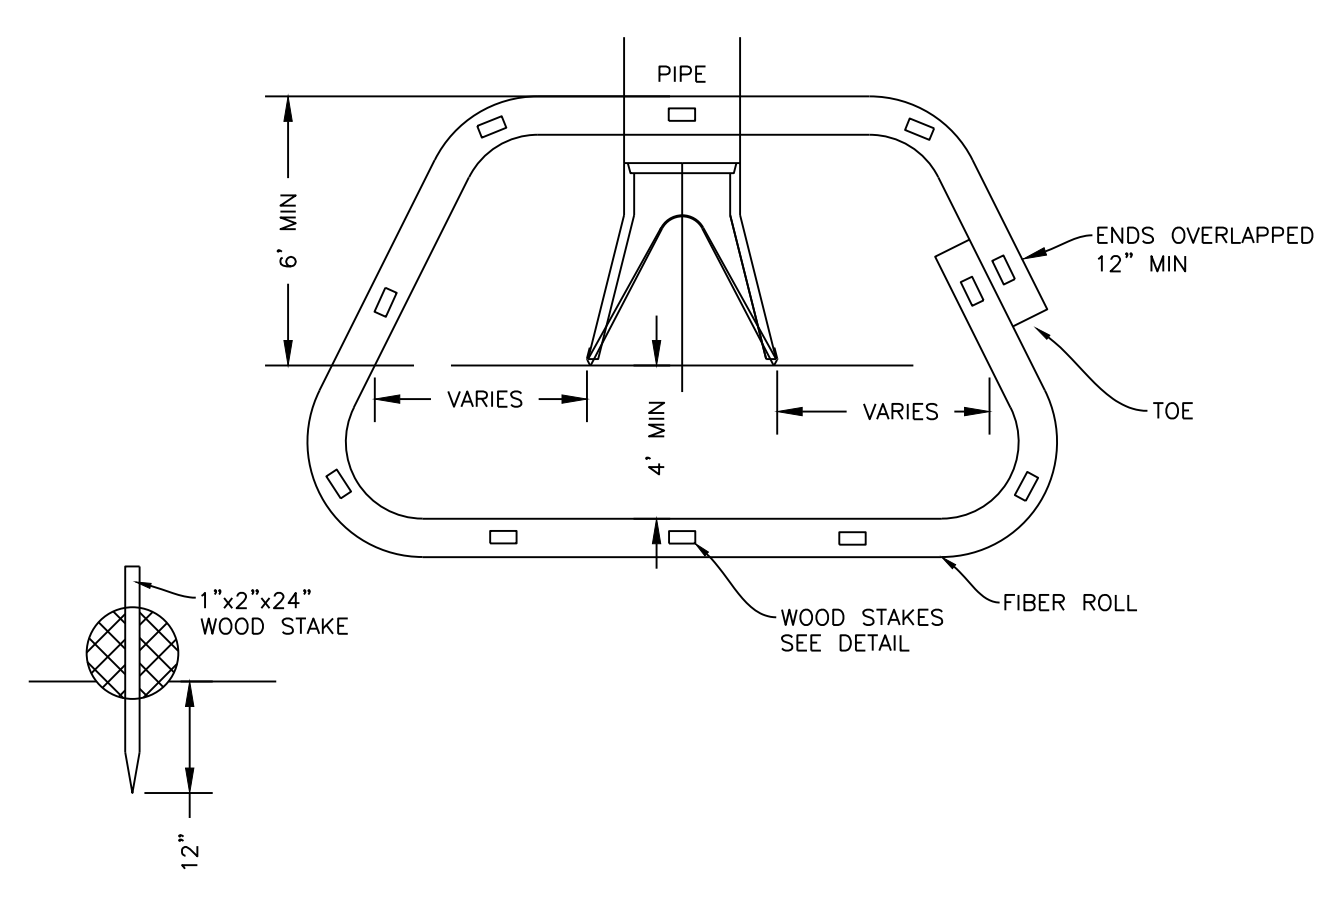


- NOTES:
1. FIBER ROLLS SHALL BE COMPOSED OF DEGRADABLE NETTING THAT CONTAINS COMPRESSED HAY OR STRAW THAT IS FREE OF SEEDS AND NOXIOUS WEEDS, OR WOOD EXCELSIOR.
  2. REMOVE SEDIMENT FROM FIBER ROLL WHEN IT REACHES 1/3 OF THE EXPOSED HEIGHT OF ANY SECTION, OR AS DIRECTED BY THE ENGINEER. THE ENGINEER MAY DIRECT THE INSTALLATION OF A SECOND FIBER ROLL IF REMOVING THE SEDIMENT DEPOSIT IS NOT FEASIBLE.
  3. FIBER ROLL SHALL BE INSPECTED EVERY 14 CALENDAR DAYS AND WITHIN 24 HOURS OF ANY STORM EVENT GREATER THAN 1/4" OF RAIN PER 24 HOUR PERIOD.

3 FIBER ROLL PROTECTION FLARED END SECTION  
N.T.S.

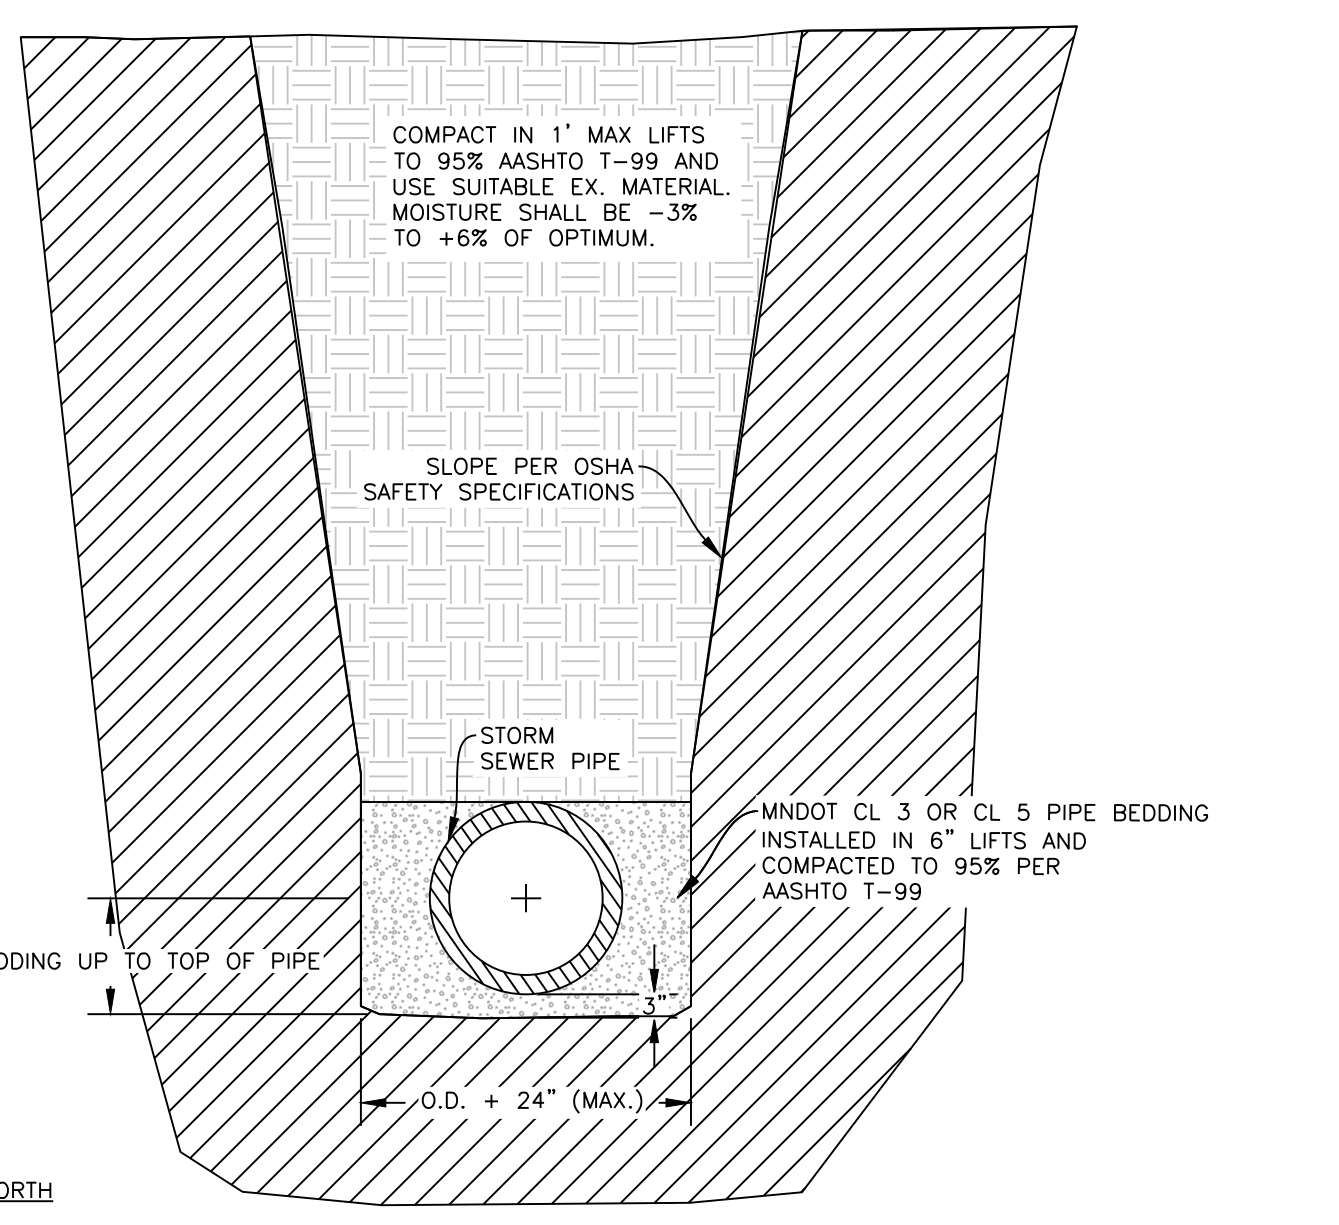


- NOTES:
1. MAXIMUM TRENCH WIDTH FOR 60", 66" & 72" NOT TO EXCEED OUTSIDE DIAMETER OF PIPE + 12" FROM BOTTOM OF TRENCH TO A POINT 2' ABOVE PIPE.
  2. LAST 3' OF PIPE MEASURE FROM BACK OF FLARED END SECTION TO BE BEDDED IN CLAY AND NOT CLASS 5 OR CLASS 3 TO PREVENT SCOUR.

8 CULVERT TRENCH  
N.T.S.

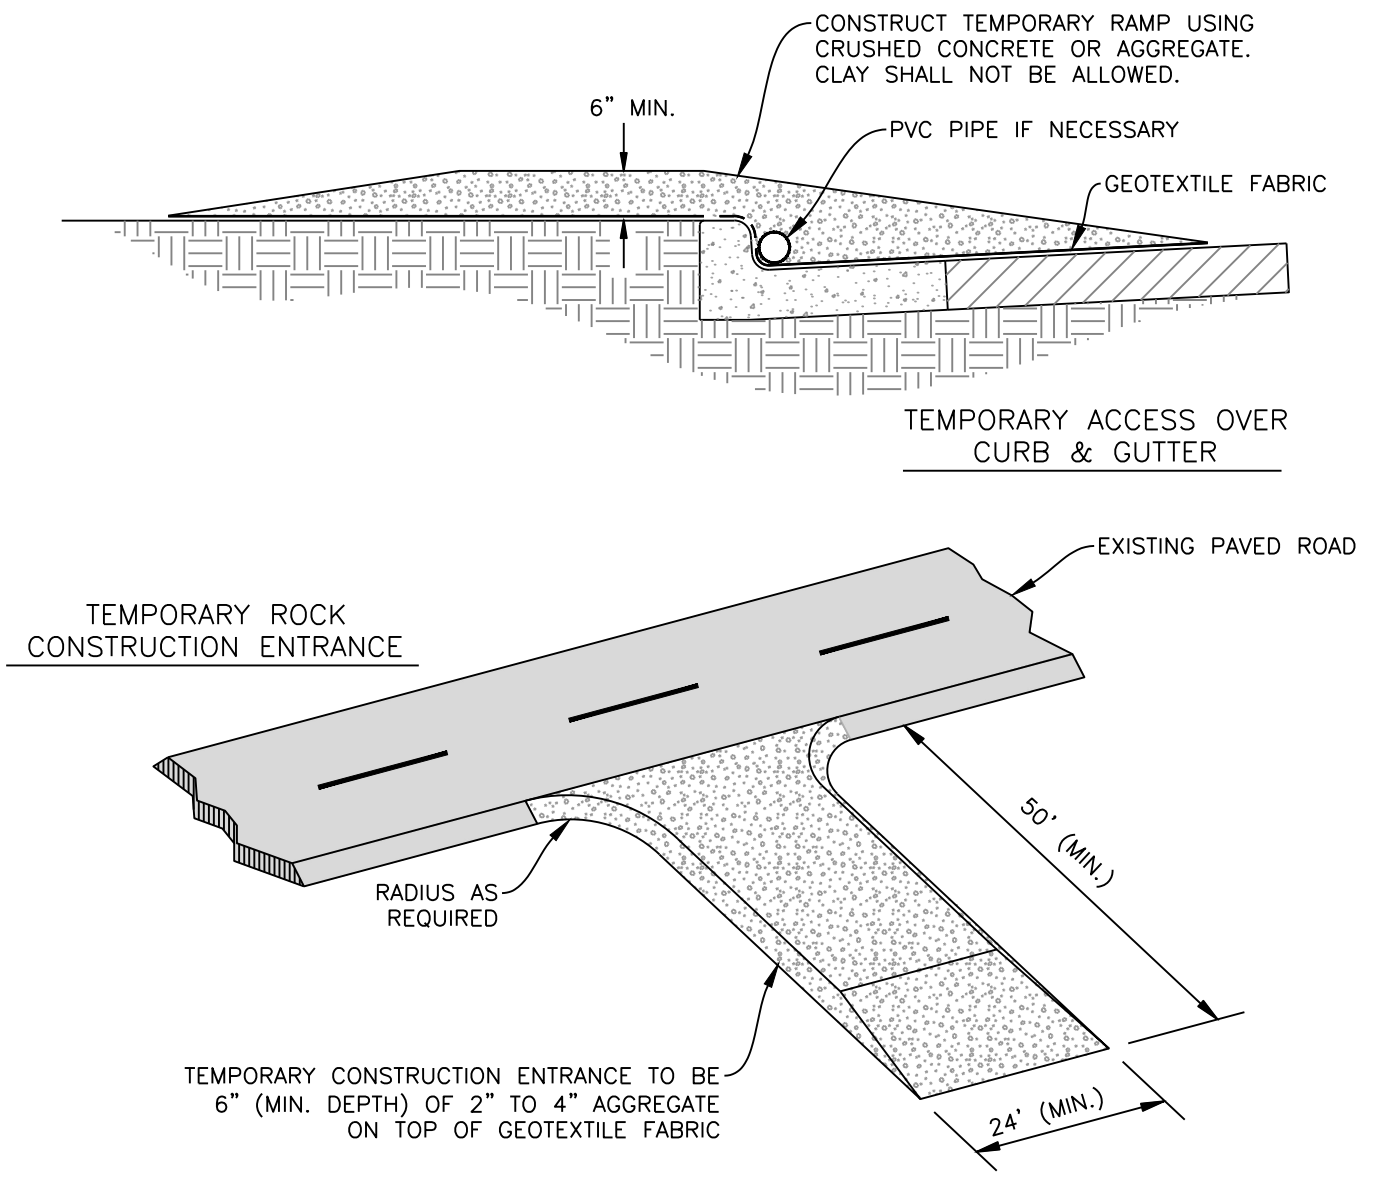


- NOTES:
1. A TEMPORARY CONSTRUCTION ENTRANCE SHALL BE CONSTRUCTED AT ALL LOCATIONS WHERE CONSTRUCTION VEHICLES OR EQUIPMENT ENTER OR EXIT THE CONSTRUCTION SITES.
  2. UPON COMPLETION OF THE PROJECT, THE CONTRACTOR SHALL REMOVE THE TEMPORARY CONSTRUCTION ENTRANCE UNLESS NOTED OTHERWISE, AND THE SITE SHALL BE RESTORED TO ITS PREVIOUS CONDITION.
  3. ENTRANCES SHALL BE MAINTAINED IN A MANNER TO MINIMIZE THE TRACKING OF SEDIMENT ONTO PAVED SURFACES.
  4. TEMPORARY ACCESS OVER EXISTING CURB AND GUTTER SHOULD BE LOCATED AT HIGH POINTS IN THE STREET IF POSSIBLE TO MAINTAIN STREET DRAINAGE.
  5. REMOVE TOPSOIL BEFORE CONSTRUCTION OF STABILIZED CONSTRUCTION ACCESS.

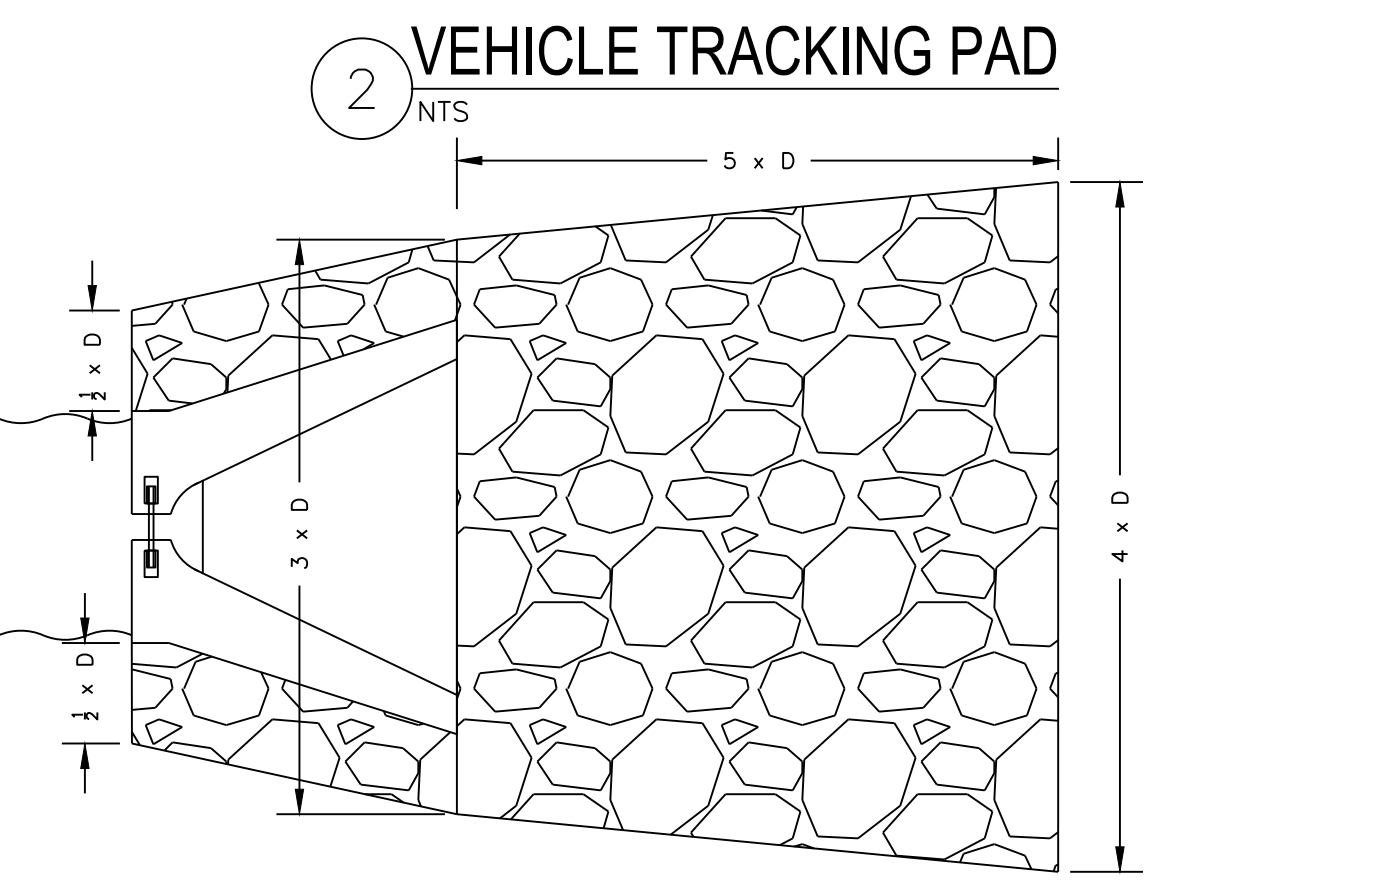


- NOTES:
1. RIPRAP SHALL MEET MNDOT SPECIFICATIONS AND/OR APPROVED BY THE ENGINEER.
  2. MNDOT TYPE 4 FABRIC SHALL BE INSTALLED UNDER RIP RAP.
  3. RIPRAP DEPTH SHALL BE 18".
  4. RIPRAP GRADATION PER PLANS

6 FES RIPRAP  
N.T.S.

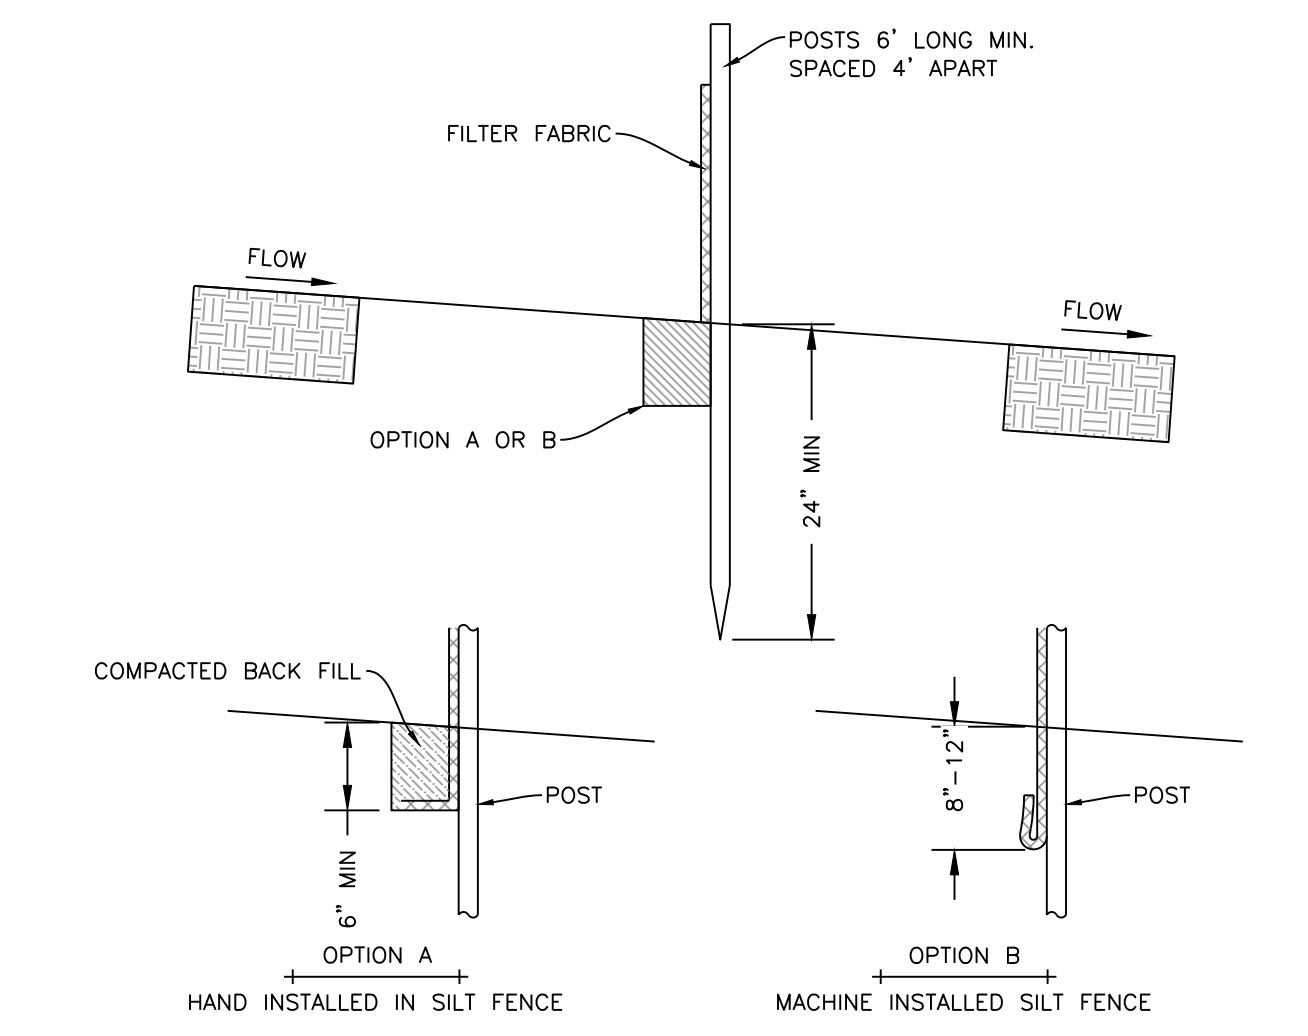


- NOTES:
1. POSTS SHALL BE 2 INCH DIAMETER ROUND WOOD, 1.5 INCH RECTANGULAR WOOD, OR STEEL WITH A MINIMUM OF 0.95 POUNDS PER FOOT AND HAVE PROJECTIONS FOR FASTENING WIRE OR FABRIC.
  2. FILTER FABRIC SHALL BE AS SPECIFIED IN AASHTO M 288 WITH A MINIMUM WIDTH OF 36 INCHES.
  3. SILT FENCE SHALL BE INSTALLED ALONG THE CONTOURS OF THE SITE SO WATER CANNOT FLOW AROUND THE END OF THE FENCE.
  4. IF JOINING TWO SECTIONS OF FILTER FABRIC, OVERLAP AT SUPPORT POSTS A MINIMUM OF 18 INCHES IN SUCH A MANNER THAT PREVENTS SILT FROM PASSING THROUGH THE FENCE.
  5. REMOVE SEDIMENT FROM SILT FENCE WHEN IT REACHES 1/3 OF THE EXPOSED HEIGHT OF ANY SECTION, OR AS DIRECTED BY THE ENGINEER. THE ENGINEER MAY DIRECT THE INSTALLATION OF ADDITIONAL SILT FENCE IF REMOVING THE SEDIMENT DEPOSIT IS NOT FEASIBLE.
  6. SILT FENCE SHALL BE INSPECTED EVERY 14 CALENDAR DAYS AND WITHIN 24 HOURS OF ANY STORM EVENT GREATER THAN 1/4" OF RAIN PER 24 HOUR PERIOD.

1 SILT FENCE INSTALLATION  
N.T.S.

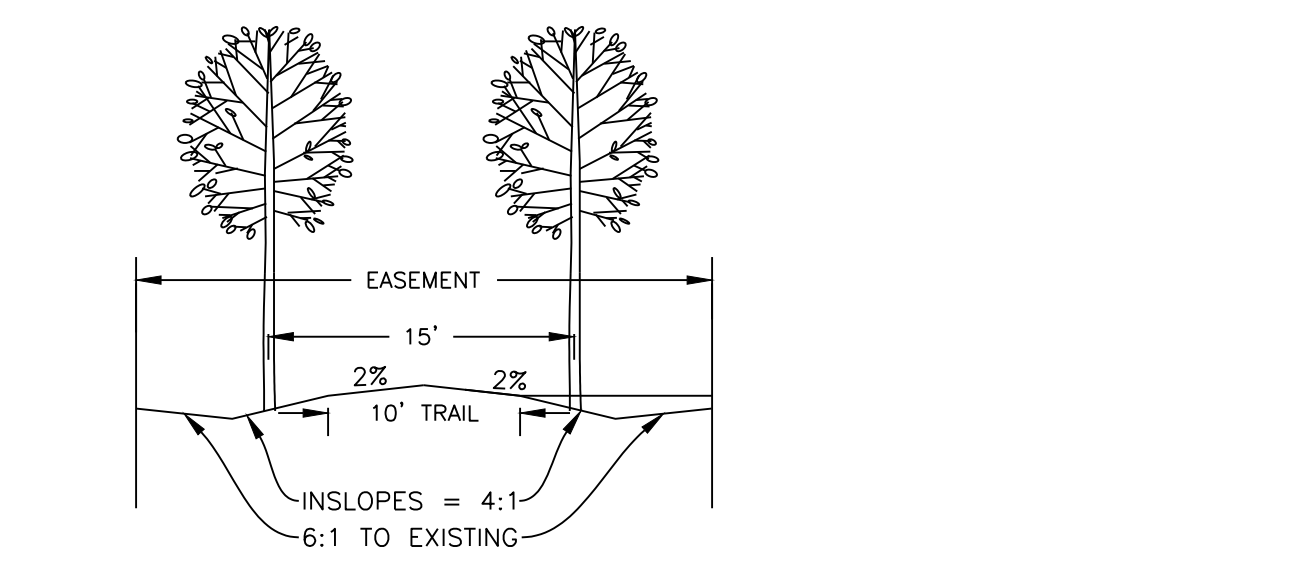


5 PEDESTRIAN ACCESS EASEMENT CROSS SECTION  
N.T.S.

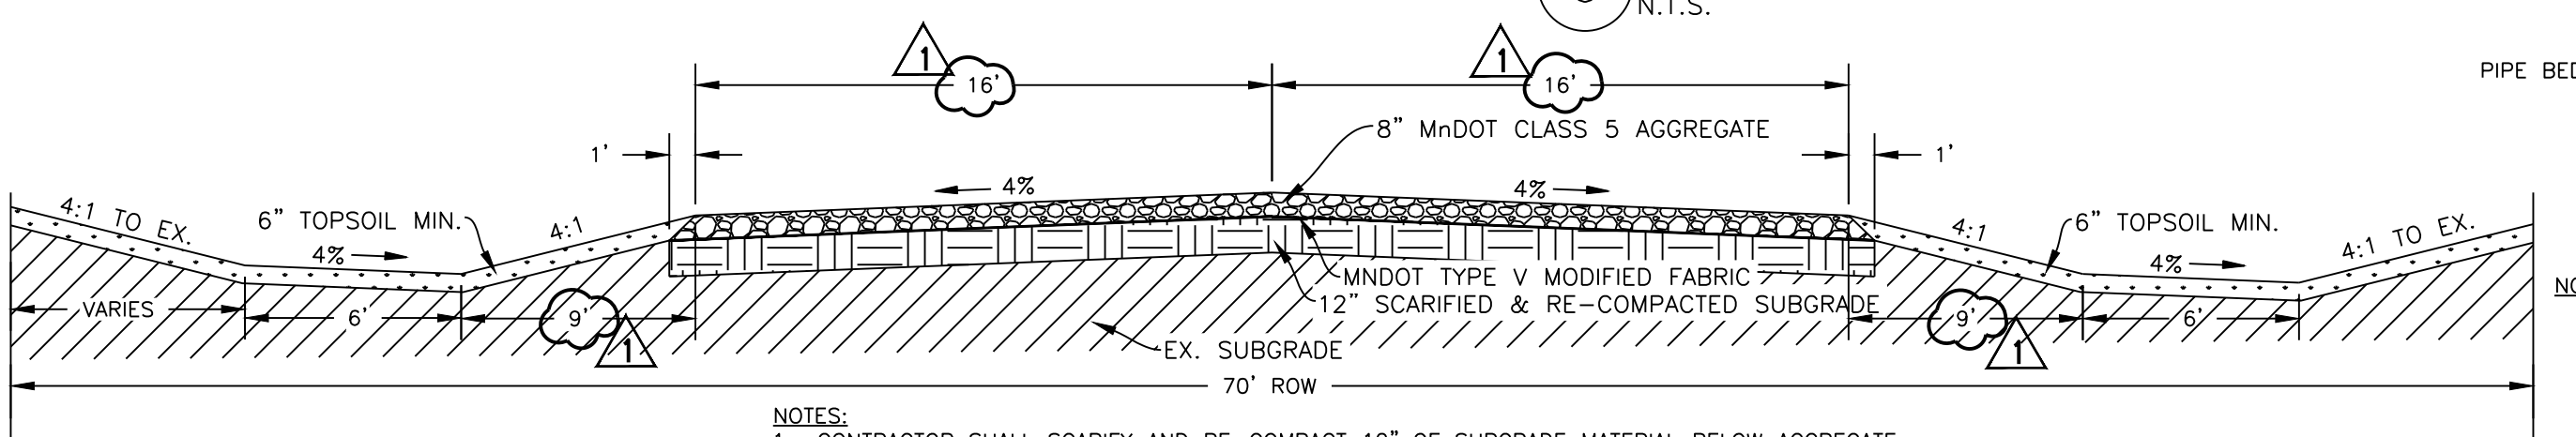

NOTES:  
1. CONTRACTOR SHALL SCARIFY AND RE-COMPACT 12" OF SUBGRADE MATERIAL BELOW AGGREGATE

7 PROPOSED TYPICAL SECTION 79TH AVENUE NORTH  
N.T.S.

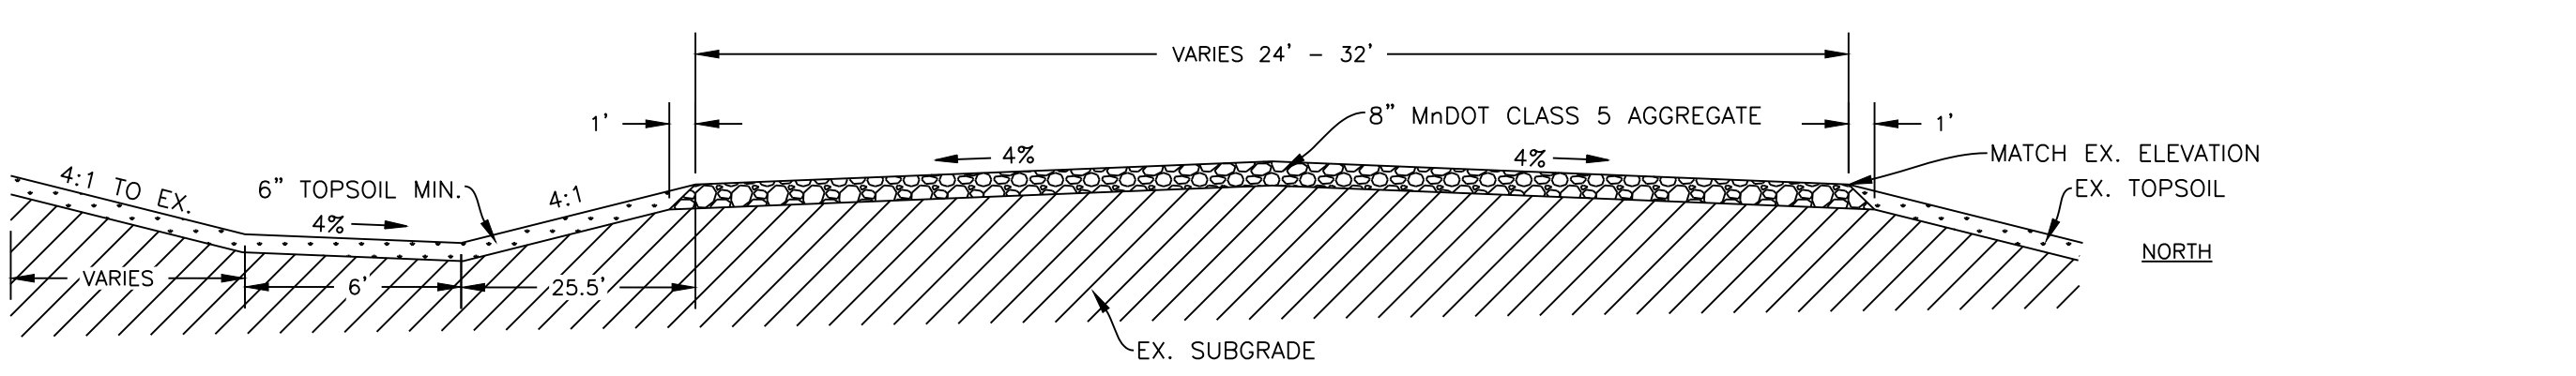

9 PROPOSED TYPICAL SECTION 80TH AVENUE NORTH  
N.T.S.

05-13-19  
REVISED 79TH AVE TO 32' WIDE

C:\Users\danielle.kukowski\AppData\Local\Temp\AutoPublish\_7500118093\_C.dwg